

Name **W. Henry Lahti**

Service No. **89**

Address **105 North Hancock St., Lexington**

**105 N. HANCOCK ST.**

Location **Comm. 11-19-56**

Kind of Pipe

Size **6"**

Size of Main

~~Repair~~ ~~Renewal~~ **New Service**

Location

Date	Material	Amount	Total	Date	Amount
7/3/56	Labor	46 41		6-27-56	Deposit \$ 200 00
	10% Overhead	4 64	51 05	11-19-56	Refund 72 96
	51-6" Sewer Pipe @.455		23 21		127 04
	Joint Compound		3 12		
	5 2/3 hrs. Littlefield Shovel		13 50		
10-15-56	10' - 4" Iron wst by Plumber insp		48 16		
	2 hrs. Trucking @.75		1 50		
			127 04		
	Labor				

**TOWN OF LEXINGTON—DEPT. OF PUBLIC WORKS**  
**SEWER DIVISION**

DATE .....

NO. ....

The undersigned applies for the construction of a particular sewer connecting No. .... Street and hereby agrees to comply with the Rules and Regulations governing the construction and use of Particular Sewers, as now or at any future time established by the Board of Selectmen.


Am't of estimate \$.....

Am't Paid \$.....

..... Owner

Sketch of Service Here

**105**

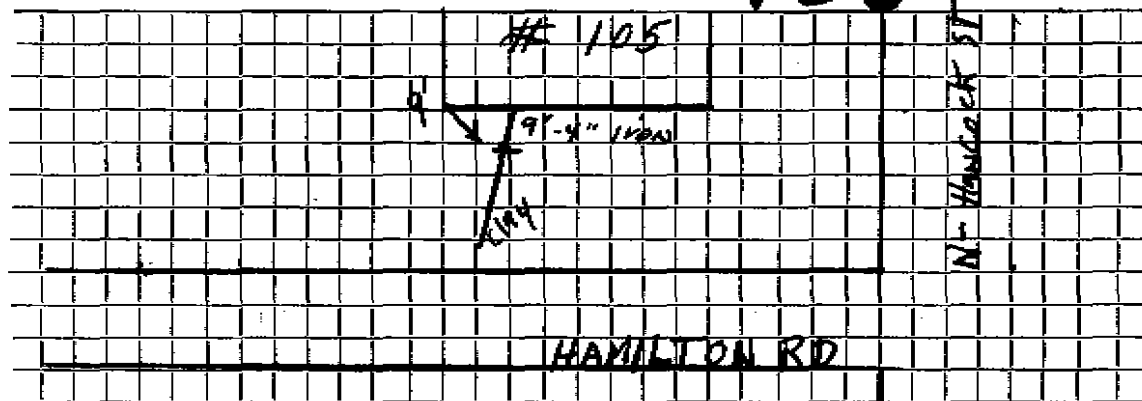

Connection made in Hamilton Rd W+S Street.

Work completed ..... 19..

Remarks: