

Name John M. McCullough

Service No. 88 1131

Address

20 N. HANCOCK ST.

Location 20 North Hancock Street

Kind of Pipe

Size

Size of Main

~~Repair~~ ~~Renewal~~ New Service

Location

Date	Material	Amount	Total	Date	Amount
12/1/47	Labor	35 10	35 10	Nov. 19 47	135 00
	10% Overhead		3 51	Dec. 31 47	44 73
	64' 6" Sewer Pipe @ .26		16 64		90 27
	1 6" Elbow		1 18		
	Joint Compound		3 84		
	1 ½ hrs. Hired Shovel @ 7.00		10 50		
	1 hr. Loader		3 00		
	2 hrs. Trucking @ .75		1 50		
	Patching 15x3		15 00		
			90 27		
	Labor				
	Com 12/31/47				

TOWN OF LEXINGTON—DEPT. OF PUBLIC WORKS

SEWER DIVISION

DATE

NO.


The undersigned applies for the construction of a particular sewer connecting No.
Street and hereby agrees to comply with the Rules and Regulations governing the construction and use of Particular
Sewers, as now or at any future time established by the Board of Selectmen.

Am't of estimate \$.....

Am't Paid \$.....

..... Owner

Sketch of Service Here

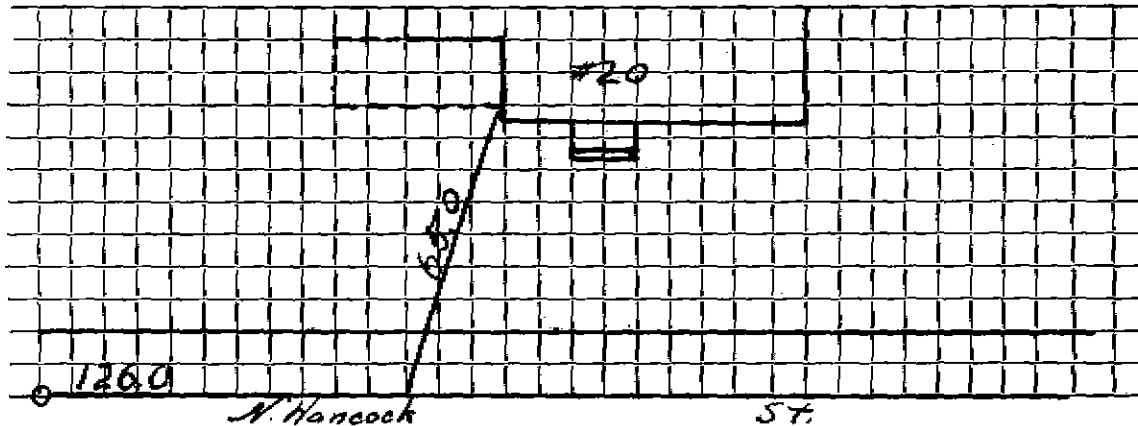

Connection made in Street.

Work completed 19..

Remarks: