

Name Franklin M. Dyer

Service No. 77
1125 ✓

Address 22 No. Hancock Street

22 N. Hancock St.

Location 22 North Hancock Street

Kind of Pipe

Size

Size of Main

~~Kind of Pipe~~ — New Service

Location

Date	Material	Amount	Total	Date	Amount
11/19/47	Labor	65 57	65 57	Nov 16 47	150 00
	10% Overhead		6 56	Dec. 31 47	20 58
	66' 6" Sewer Pipe		17 16		129 42
	Joint Compound		3 96		
	2 hrs. Hired Shovel @ 7.00		14 00		
	2 hrs. Loader @ 3.00		6 00		
	2 hrs. Trucking @ .75		1 50		
	Patching 11x4		14 68		
			129 42		
	Repair Clearway Permit #3564				
-27-81	5' repaired at foundation				
	Labor				
	Com 12/31/47				
HP-6411					

TOWN OF LEXINGTON—DEPT. OF PUBLIC WORKS

SEWER DIVISION

DATE

NO.


The undersigned applies for the construction of a particular sewer connecting No. Street and hereby agrees to comply with the Rules and Regulations governing the construction and use of Particular Sewers, as now or at any future time established by the Board of Selectmen.

Am't of estimate \$.....

Am't Paid \$.....

..... Owner

Sketch of Service Here

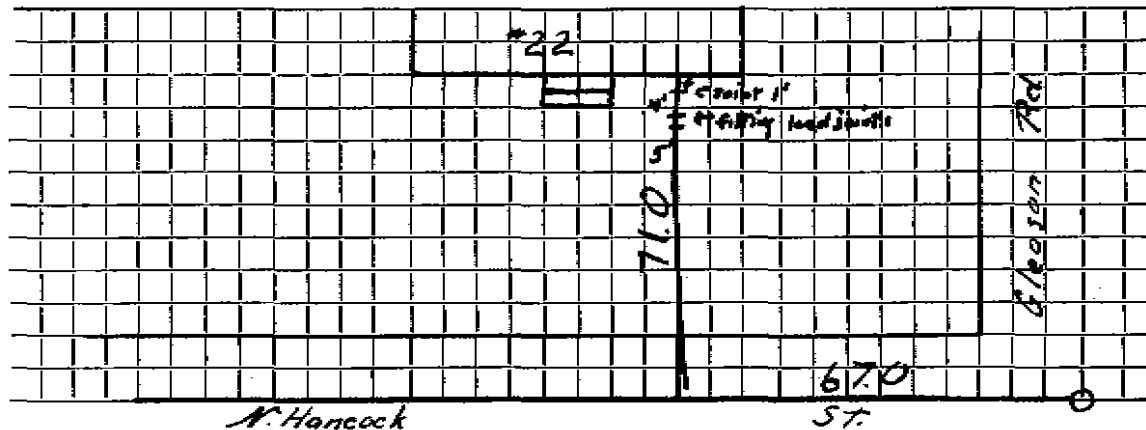

Connection made in Street.

Work completed 19..

Remarks: