




TOWN OF LEXINGTON — BOARD OF PUBLIC WORKS

SEWER DIVISION

Sketch of Service Here **23**

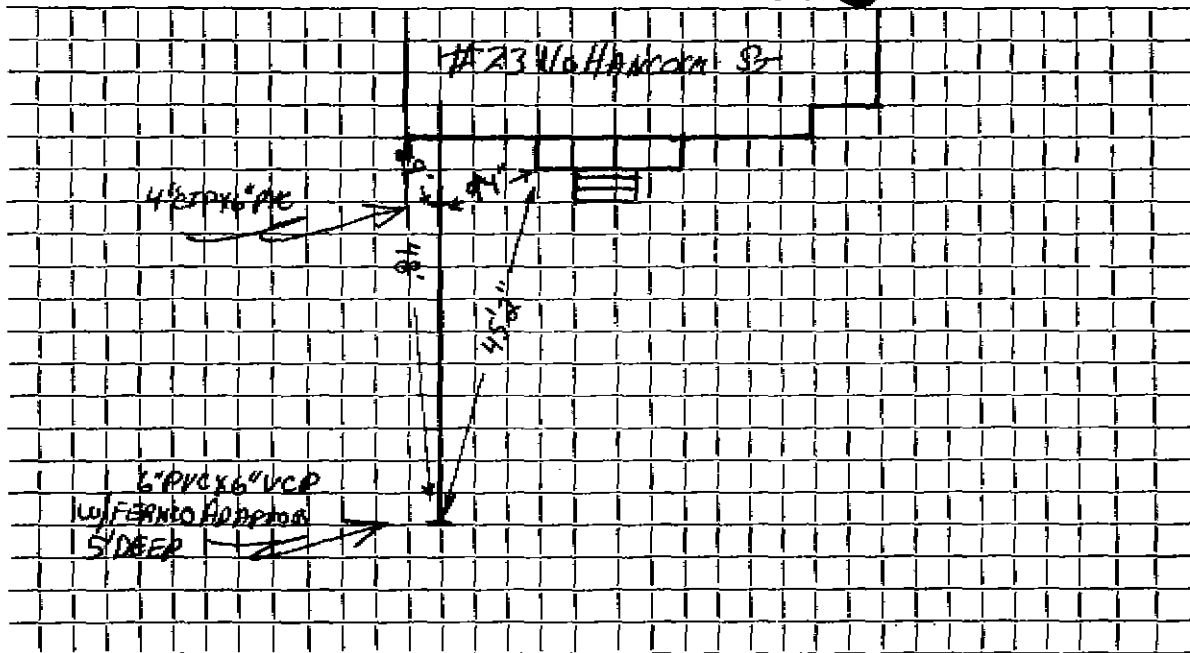

Connection made in No. Hancock St Street. Work completed .....

Remarks: Original Service 2-24-53 (58'-6" Sewer Pipe, 1-6" Elbow)

.....

.....