

Name **Fred Glady, Jr.**

Service No. **43**

Address **25 North Hancock St.**

Lexington

Location

Kind of Pipe

Size

Size of Main

~~NEW SERVICE~~ New Service COM. 7-28-52

Location

Date	Material	Amount	Total	Date	Amount
5/28/52	Labor	49 05		4-17-52	Deposited 175 00
	10% overhead	4 91	53 96	7-28-52	Refunded 31 95
	54' - 6" sewer pipe @ .342		18 47		143 05
	1 - 6" elbow		1 88		
	joint compound		3 24		
	7 hrs. Littlefield shovel		49 00		
	2 hrs. trucking		1 50		
	patching 15 x 3		15 00		
			<u>143 05</u>		
	Labor				

TOWN OF LEXINGTON—DEPT. OF PUBLIC WORKS
SEWER DIVISION

DATE.....

NO.


The undersigned applies for the construction of a particular sewer connecting No.....
Street and hereby agrees to comply with the Rules and Regulations governing the construction and use of Particular
Sewers, as now or at any future time established by the Board of Selectmen.

Am't of estimate \$.

Am't Paid \$.

..... Owner

Sketch of Service Here

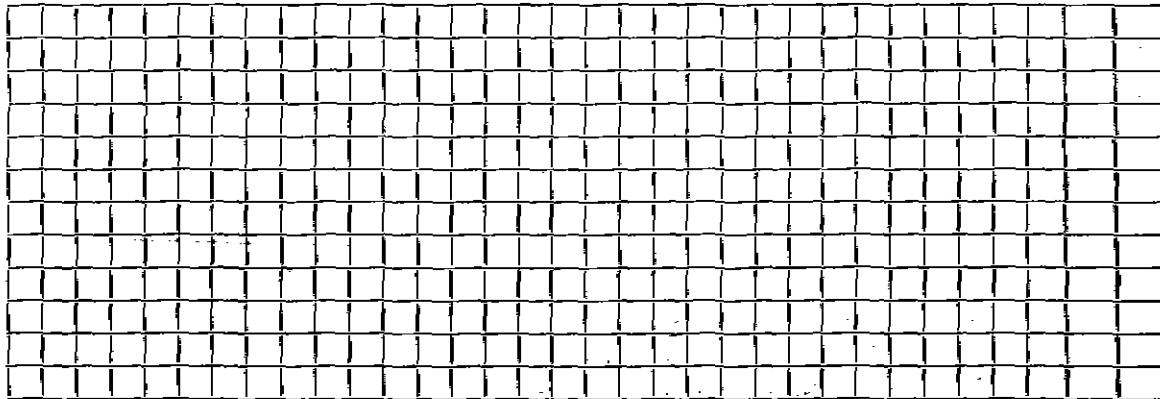

Connection made in..... Street. Work completed..... 19..

Remarks: