

104

Name **Lowell Const. Company**

Service No.

Address **29 N. Hancock Street**

Lexington, Mass.

Location

Kind of Pipe

Size

Size of Main

~~Repair~~ ~~Renewal~~ ~~Work~~ **New Service**

Location

Date	Material	Amount	Total	Date		Amount
pt. 21, '48	Labor	29 85	29 85	Sept 16 '48	Deposited	125 00
	10% Overhead		2 99	Dec 31 '48	Refunded	25 92
	82' - 6" Sewer Pipe @ .26		21 32			79 08
	Joint Compound		4 92		OUTSIDE	
	3 1/2 hrs. Littlefield Shovel		24 50	6/15/84	4 1/2' PVC 6" Pipe	
	2 hrs. Trucking		1 50		2 Pennco 6" Adapters clay to PVC	
	Patching 14 x 3		14 00		Curb Box Ext 1'	
-4- 87			99 08		12 yds. Gravel	
	286' - 6" P.V.C.					
	1 6" x 6" P.V.C. to Clay Pennco			4-29-87	Flat Spot	
				4-12-87	Solids 68'	
				2-11-74	Solids	
	Labor			10-7-78	Solids 55' to 60' out	
				12-8-78	Solids " " " "	
				12-29-8	Solids " " " "	
				1-3-84	Solids 65-72 1/4'	

TOWN OF LEXINGTON—DEPT. OF PUBLIC WORKS
SEWER DIVISION

DATE

NO.


The undersigned applies for the construction of a particular sewer connecting No.
 Street and hereby agrees to comply with the Rules and Regulations governing the construction and use of Particular
 Sewers, as now or at any future time established by the Board of Selectmen.

Am't of estimate \$.....

Am't Paid \$.....

..... Owner

Sketch of Service Here **29**

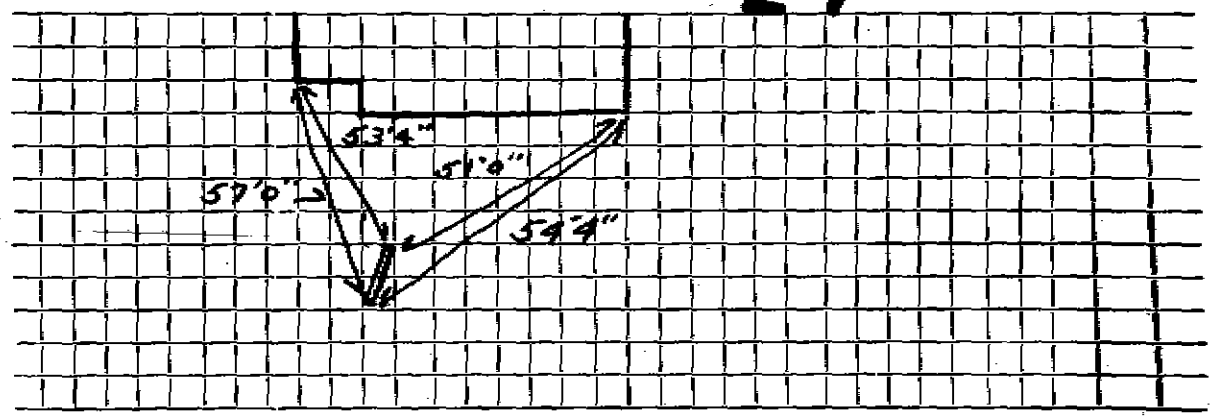

Connection made in Street.

Work completed 19..

Remarks: