

Name Malcolm Young

Service No. 36

Address 31 N. Hancock St.

Lexington

Location

Kind of Pipe

Size

Size of Main

~~REPAIR WORK~~ New Service

COM. 4-6-53

Location

Date	Material	Amount	Total	Date	Amount
3/25/53	Labor	58 70		3-19-53	Deposited 150 -
	10% overhead	5 87	64 57	4-6-53	Refunded (1 13
	56'-5" Transite Pipe @.55		30 80		148 87
	6 Hr. Littlefield Shovel	7.00	42 00		
	2 Hr. Trucking		1 50		
	Patching 10 x 3		10 00		
			148 87		
	Labor				

TOWN OF LEXINGTON—DEPT. OF PUBLIC WORKS
SEWER DIVISION

DATE.....

NO.


The undersigned applies for the construction of a particular sewer connecting No.....
Street and hereby agrees to comply with the Rules and Regulations governing the construction and use of Particular
Sewers, as now or at any future time established by the Board of Selectmen.

Am't of estimate \$.....

Am't Paid \$.....

..... Owner

Sketch of Service Here

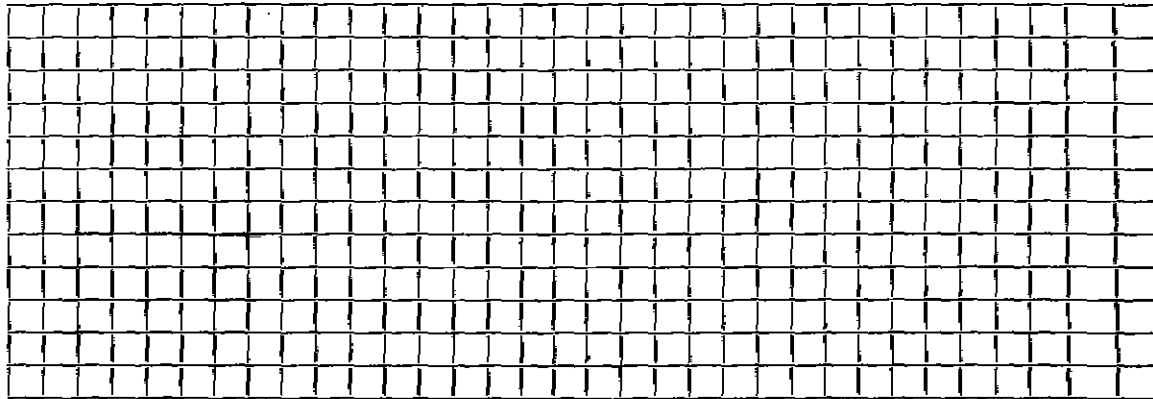

Connection made in..... Street.

Work completed.....19..

Remarks: