

Name **Leonard J. Colwell**

Service No. **85**

Address **36 North Hancock Street**

**36 N. Hancock St.**

Location

Kind of Pipe

Size **6"**

Size of Main

~~REPAIR-RENEWAL~~ ~~RENEWAL~~

WO# **2662**

Location

*Comm 11-1-66*

Date	Material	Amount	Total	Date	Amount
0-66	Labor	83 22		6-30-66	Deposit 300 00
	10 % O.H.	8 32	91 54	11-1-66	Returned 91 50
56'	6" Transite Pipe @ .88		49 28		108 43
1	11 1/2 Bend		4 09		
5	Yard Loam @ 3.00		15 00		
5	Lbs Grass seed @ 1.05		5 25		
2	Hrs. Town Truck @ 3.00		6 00		
4	Hrs. Tractor @ 6.50		26 00		
			197 16		
	<b>PRO-RATED</b> $197.16 \times 13.75 = 108.43$				
	25				


DATE \_\_\_\_\_

TOWN OF LEXINGTON — BOARD OF PUBLIC WORKS

SEWER DIVISION

Sketch of Service Here

36

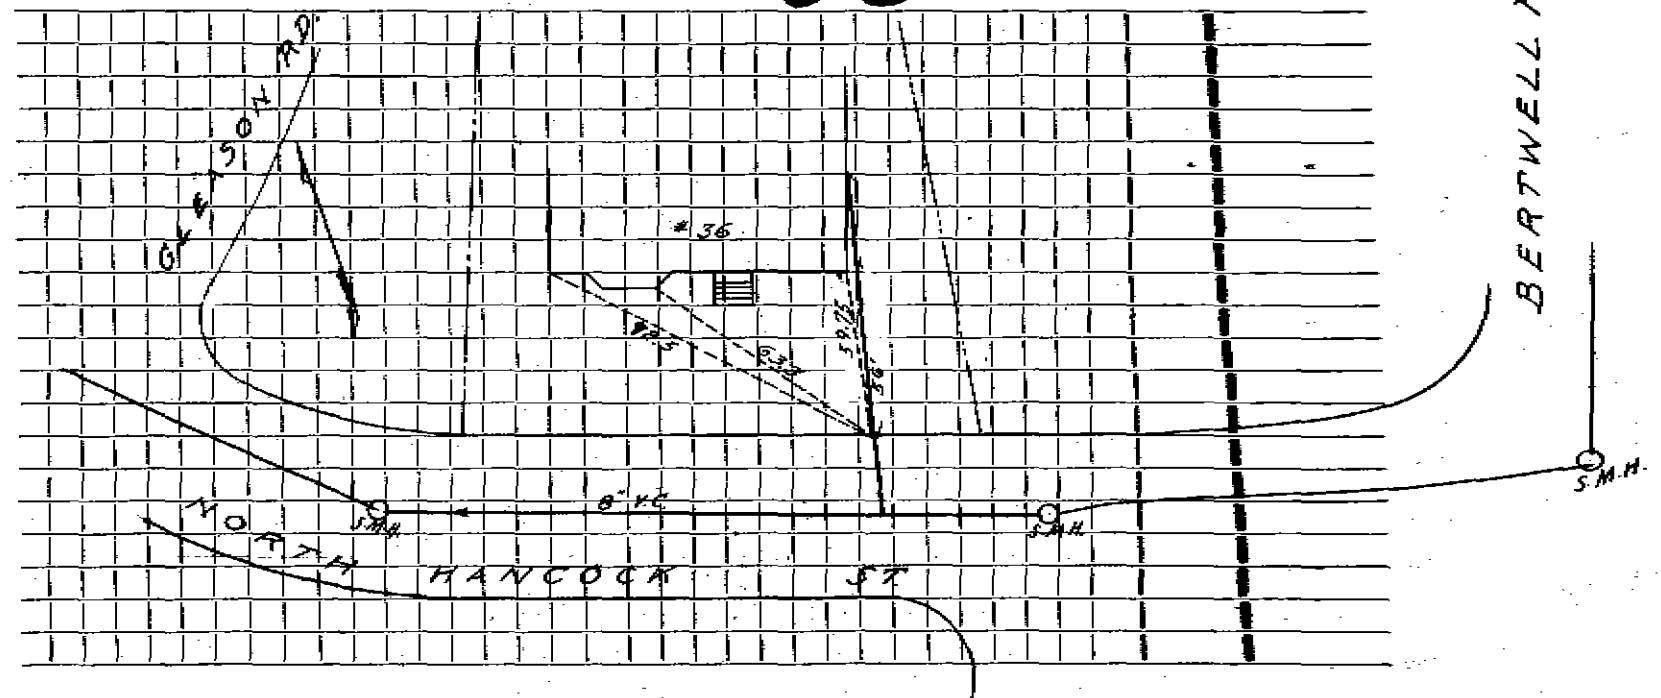

Connection made in \_\_\_\_\_ Street. Work completed \_\_\_\_\_

Remarks: Original Service 9-9-52 (86'-6" Sewer Pipe, 1-6" Elbow)