


TOWN OF LEXINGTON — BOARD OF PUBLIC WORKS

SEWER DIVISION

DATE _____

39

Sketch of Service Here

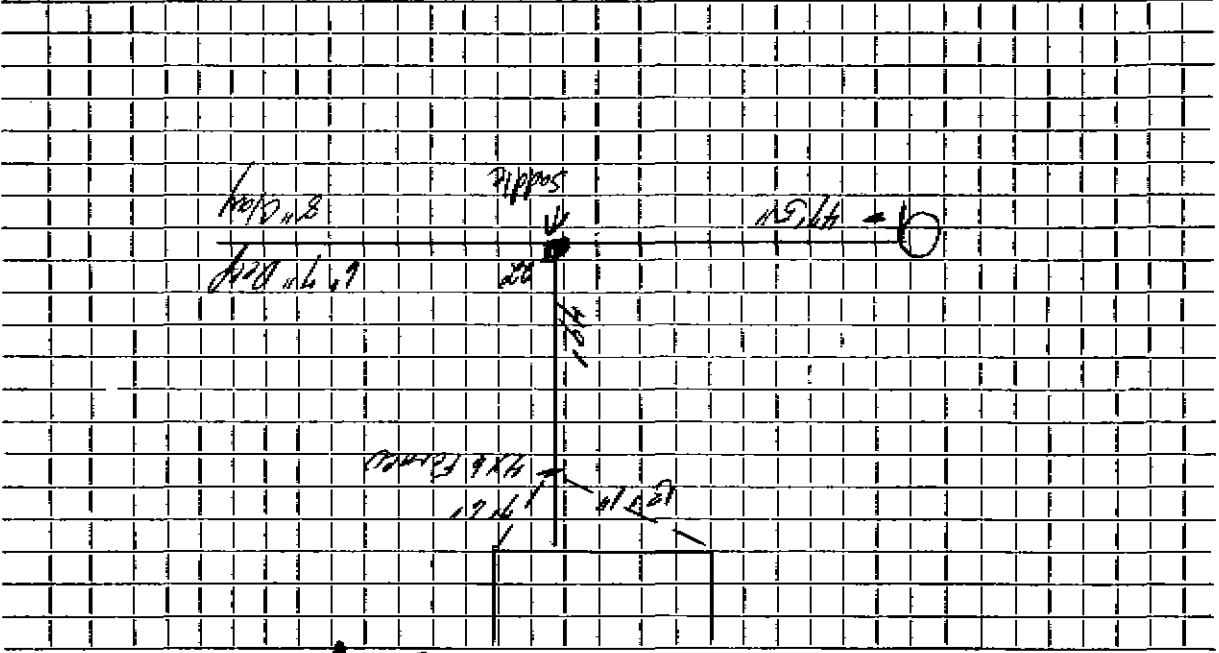

Connection made in _____

Street, _____

Work completed _____

Remarks: _____