

Name

Service No. 2439

Address 40 North Hancock St

Lot 111

Locations

Kind of Pipe PVC - Clay

Repair - Renewal - New Service

J. McLaughlin

Size of Main
Size "6"

Locations

Size of Main

Locations

Date Material Amount Total Date Amount

5/24/01 6' 4" Sch 40 PVC
56' 6" PVC

1 4X6 Ferco

2 6" - 2 2° bends


1 6" - Clay x Plaster

Exist ST 6" Clay

9/10/52

Remarks:

Connection made in Street, Work completed 5/24/07 - May 24, 2007.

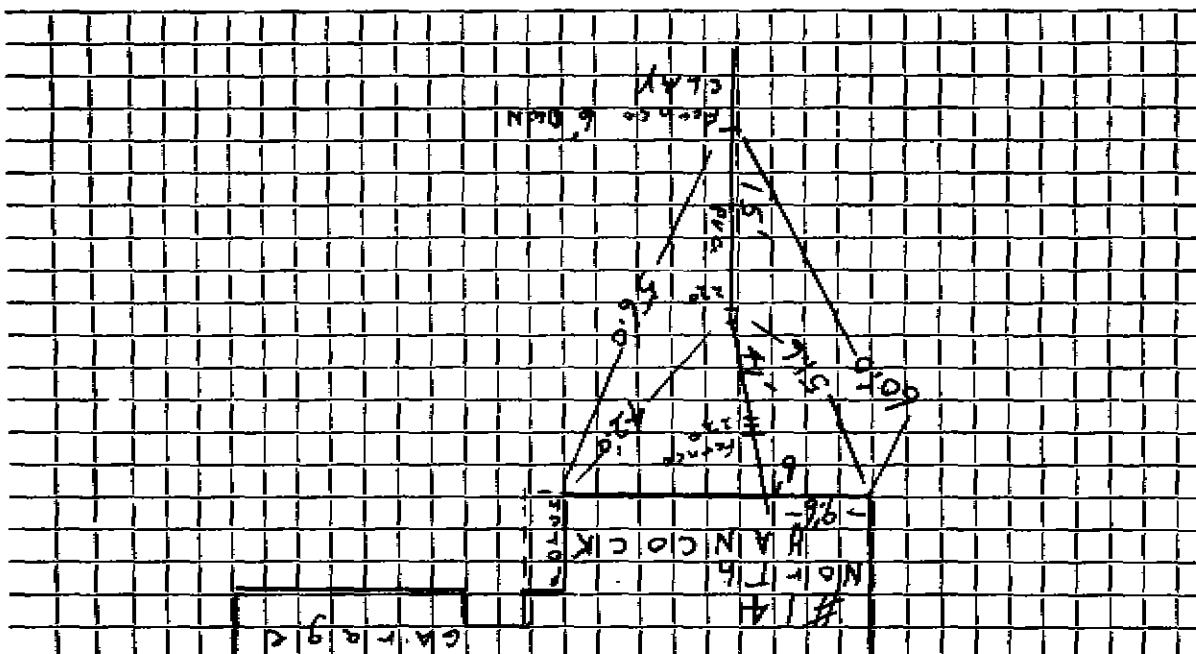

Sketch of Service Here

SEWER DIVISION

TOWN OF LEXINGTON — BOARD OF PUBLIC WORKS

DATE