


DATE _____

TOWN OF LEXINGTON — BOARD OF PUBLIC WORKS
SEWER DIVISION

Sketch of Service Here

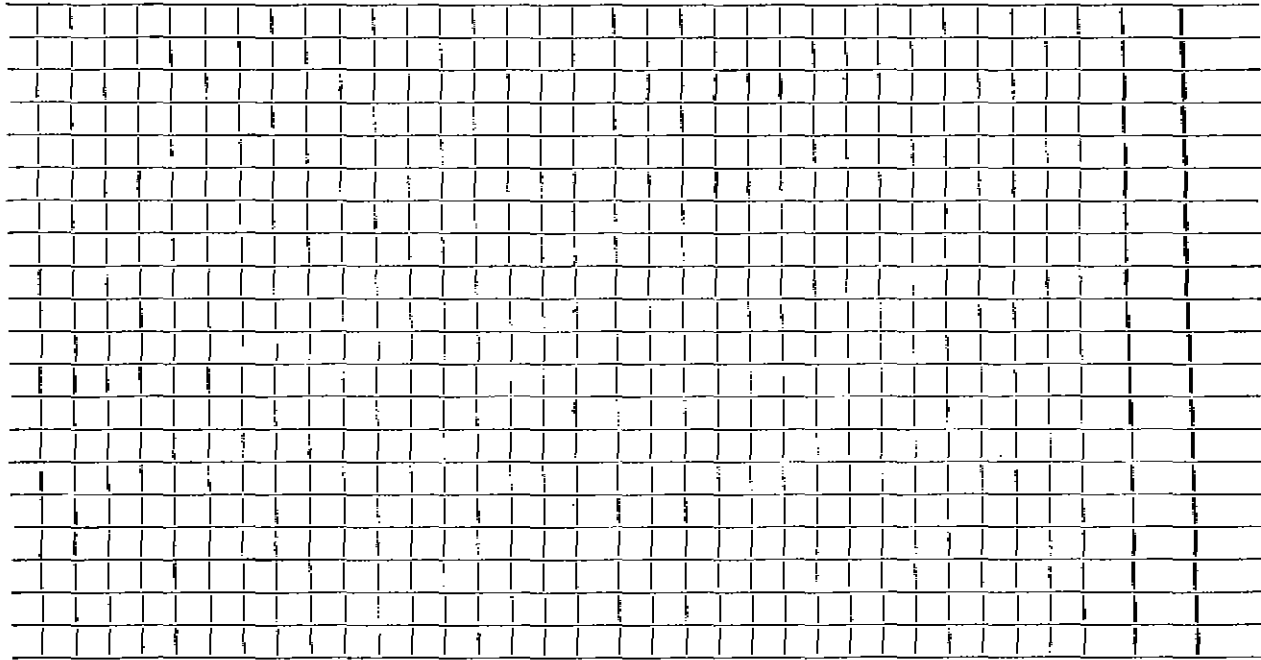

Connection made in Street. Work completed

Remarks: Original Service 5-12-48 (52'-6" Sewer Pipe, Repair 11-17-52
16'-6" sewer Pipe)