

Burton E. Stuart

Service No. 21

Address 19 N. Hancock Street

Lexington, Mass.

Location 19 N. Hancock Street

Kind of Pipe

Size

Size of Main

~~REPAIR~~ New Service

Com. June 27, 1949

Location

Date	Material	Amount	Total	Date	Amount
4, '49	Labor	63 90		April 29 '49	175 00
5, '49	"	35 73	99 63	June 30 '49	12 09
	10% Overhead		9 96		No Charge
	54' - 6" Sewer Pipe @.27		14 58	May 5, '49	Labor
	Joint Compound		3 24	6' - 6" Sewer Pipe @.27	1 62
	Littlefield Shovel 2 hrs. @7.00	14 00		Joint Compound	36
	Trucking 2 hrs. @.75		1 50	Littlefield Shovel 1 hr. @ 7.00	7 00
	Patching 13 x 3		13 00	Patching 6 x 3	6 00
			155 91		29 98
	Labor				
				12-16-56	Roots @ 2.00
				5-25-66	Roots
				6/11/76	Roots

TOWN OF LEXINGTON—DEPT. OF PUBLIC WORKS

SEWER DIVISION

DATE

NO.


The undersigned applies for the construction of a particular sewer connecting No.
Street and hereby agrees to comply with the Rules and Regulations governing the construction **and use of Particular**
Sewers, as now or at any future time established by the Board of Selectmen.

Am't of estimate \$.....

Am't Paid \$.....

..... Owner

Sketch of Service Here

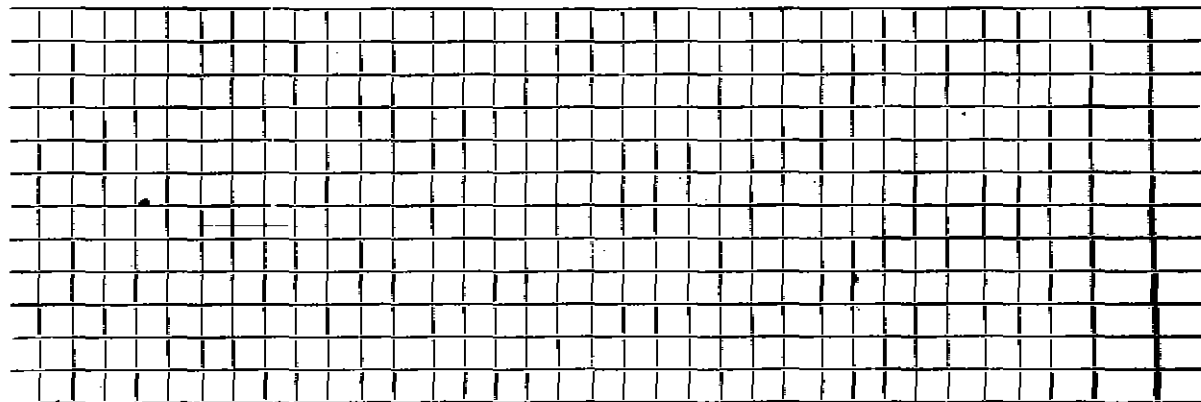

Connection made in Street.

Work completed 19..

Remarks: