

Name **Compton Brothers**

Service No. **81**

Address **55 North Hancock Street
Lexington, Mass.**

Location **55 North Hancock Street**

Kind of Pipe

Size

Size of Main

~~Repair/Removal~~ **New Service**

Com. **12-31-50**

Location

Date	Material	Amount	Total	Date	Amount
Oct. 25, '50	Labor	43 97	43 97	Sept. 15, '50	150 00
	10% Overhead		4 40		6 33
	70' - 6" Sewer Pipe		19 60		143 67
	Joint Compound		4 20		
	Littlefield Shovel 8 hrs. @7.00		56 00		
	Trucking 2 hrs. @.75		1 50		
	Patching 14 x 3		14 00		
			143 67		
	Labor				

TOWN OF LEXINGTON—DEPT. OF PUBLIC WORKS

SEWER DIVISION

DATE

NO.


The undersigned applies for the construction of a particular sewer connecting No.
Street and hereby agrees to comply with the Rules and Regulations governing the construction and use of Particular
Sewers, as now or at any future time established by the Board of Selectmen.

Am't of estimate \$.....

Am't Paid \$.....

..... Owner

Sketch of Service Here

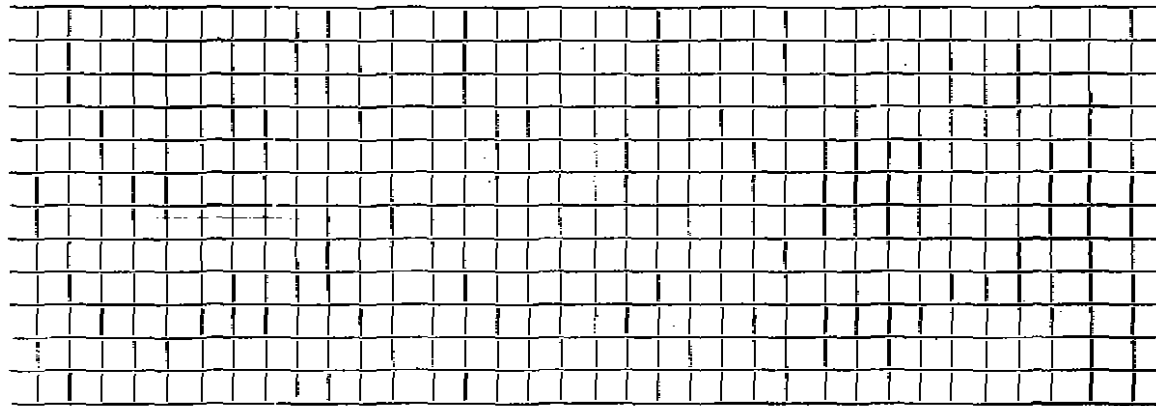

Connection made in Street.

Work completed 19..

Remarks: