

Name Norman Foskett

Service No. 77

Address 59 Hancock Street

W.O. #77

Location

Kind of Pipe

Size

Size of Main

~~REPAIR~~ Renewal ~~REPAIR~~

Location

DEC 28 1964


Date	Material	Amount	Total	Date	Amount
-22-64	Labor 40.16			55-64	Deposit 175.00
-23-64	" 94.91			12-28-64	Retrad 49.39
-24-64	" 20.50	155 57			125.41
	10% O.H.	15 56	171 13		
58'	6" Transite Pipe @.82		47 56		
1	11 1/4" Transite Bend		4 09		
4	X 3 Patch		4 00		
4	Yds. Loam @3.00		12 00		
3	Hrs. Town Shovel		19 50		
3	Hrs. Town Trucking @3.00		3 00		
			267 28		
	PRO-RATE				
	267.28/25 X 11.75 = 125.61				

DATE _____

TOWN OF LEXINGTON — BOARD OF PUBLIC WORKS

SEWER DIVISION

Sketch of Service Here **59**

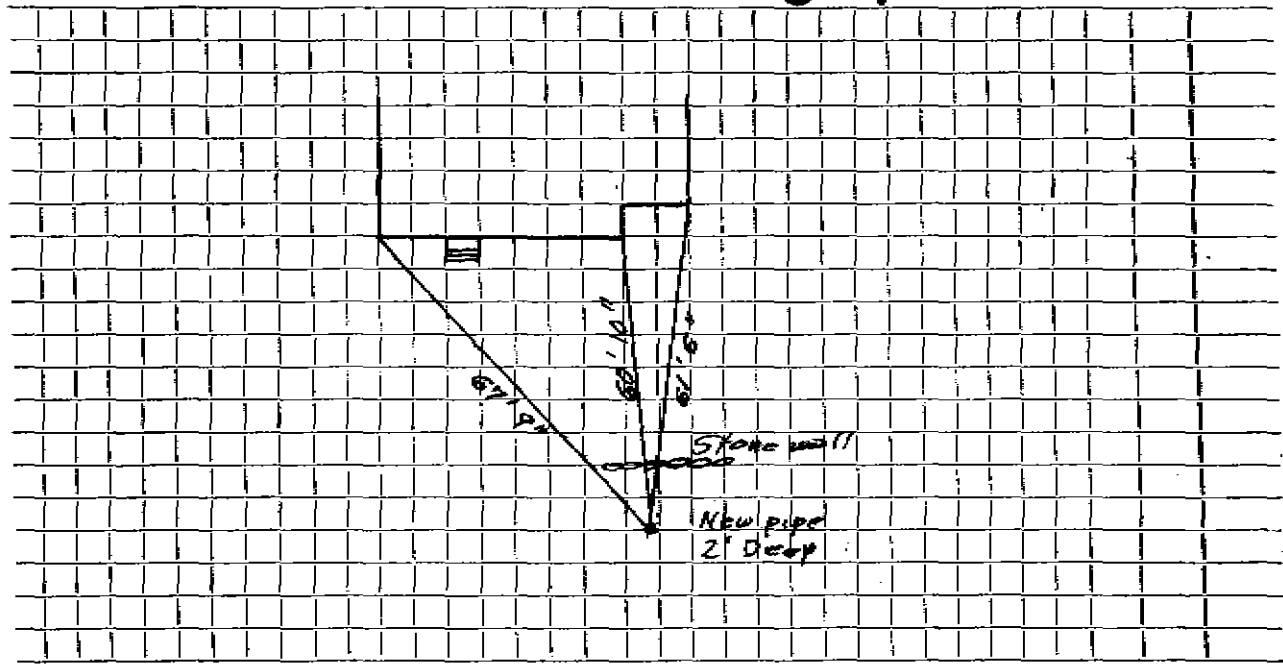

Connection made in Street. Work completed

Remarks: *Original Service 9-22-52 (60'-6" Sewer Pipe, 1'-6" E.I. box)*