

Name **Franco Napoli**

Service No. **1109**

Address **6 North Hancock Street**

Lexington, Mass.

Location **6 North Hancock St.**

Kind of Pipe

Size **6"**

Size of Main

~~Repair~~ **New Service**

Location

Date	Material	Amount	Total	Date	Amount
Oct. 31, '47	Labor	30 35	30 35	Oct 29 '47	Deposited 20 00
	10% Overhead		3 04	Nov 29 '47	Refunded 11 67
	42' - 6" Sewer Pipe @.26		10 92		78 33
	Joint Compound		2 52		
	Hired Shovel 3 hrs. @7.00		21 00		
	Trucking 2 hrs. @.75		1 50		
	Patching 9 x 3		9 00		
			<u>78 33</u>		
	Labor				
	Com - 11.24.47				

TOWN OF LEXINGTON—DEPT. OF PUBLIC WORKS

SEWER DIVISION

DATE

NO.


The undersigned applies for the construction of a particular sewer connecting No. Street and hereby agrees to comply with the Rules and Regulations governing the construction and use of Particular Sewers, as now or at any future time established by the Board of Selectmen.

Am't of estimate \$.....

Am't Paid \$.....

..... Owner

Sketch of Service Here **6**

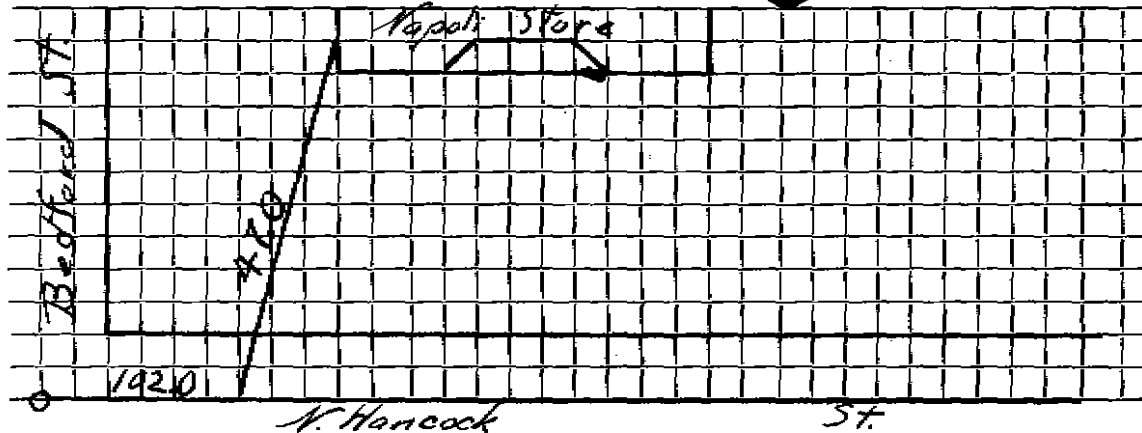

Connection made in Street.

Work completed 19..

Remarks: