


DATE MARCH 27, 1984

TOWN OF LEXINGTON — BOARD OF PUBLIC WORKS
SEWER DIVISION

Sketch of Service Here

#63 No HANCOCK ST

63

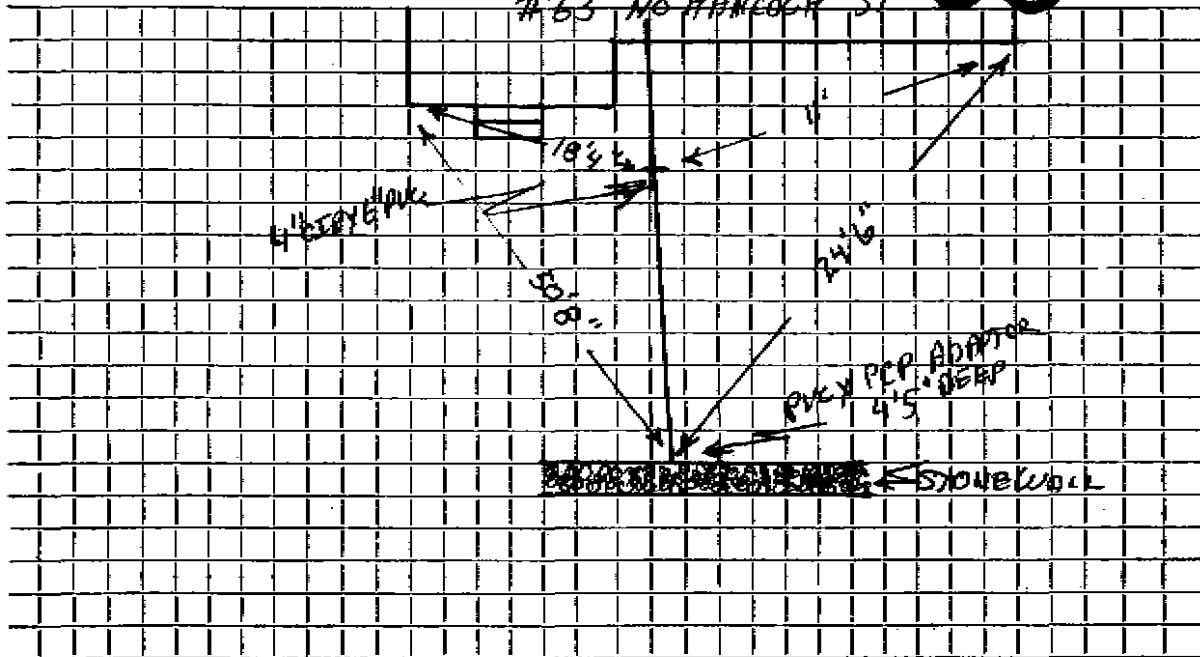

Connection made in No. HANCOCK ST Street. Work completed

Remarks: ORIGINAL SERVICE INSTALLED JULY 1948 WITH 60' OF P.C.P. (HEALIX ENNIS Home owner)
\$123.97