


DATE 8-31-02

TOWN OF LEXINGTON — BOARD OF PUBLIC WORKS
SEWER DIVISION

Sketch of Service Here

67

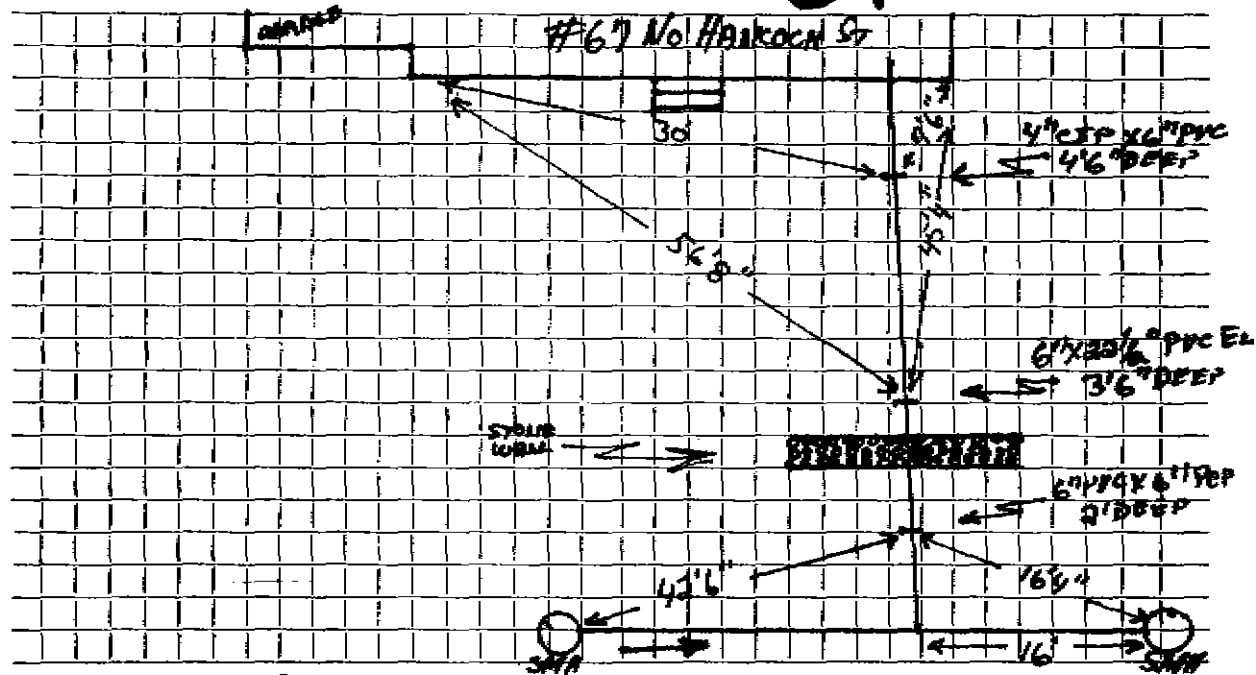

Connection made in No HANCOCK ST Street. Work completed

Remarks: