

Name **Richard W. Dow**

Service No. **29**

Address **71 North Hancock Street**

**Lexington**

Location

Kind of Pipe

Size

Size of Main

~~XXXXXXXXXX~~ New Service COM. 6-16-52

Location

Date	Material	Amount	Total	Date	Amount
1/22/52	Labor	37 01		4-7-52	Deposited 150 00
	10% overhead	3 70	40 71	6-16-52	Refunded (33 13)
	34' - 6" sewer pipe @ .342		11 62		116 87
	joint compound		2 04		
	7 hrs. Littlefield shovel		49 00		
	2 hrs. trucking		1 50		
	patching 12 x 3		12 00		
			116 87		
	<b>Labor</b>				

# TOWN OF LEXINGTON—DEPT. OF PUBLIC WORKS

## SEWER DIVISION

DATE .....

NO. ....


The undersigned applies for the construction of a particular sewer connecting No. ....  
Street and hereby agrees to comply with the Rules and Regulations governing the construction **and use of Particular**  
Sewers, as now or at any future time established by the Board of Selectmen.

Am't of estimate \$.....

Am't Paid \$.....

..... Owner

**Sketch of Service Here**

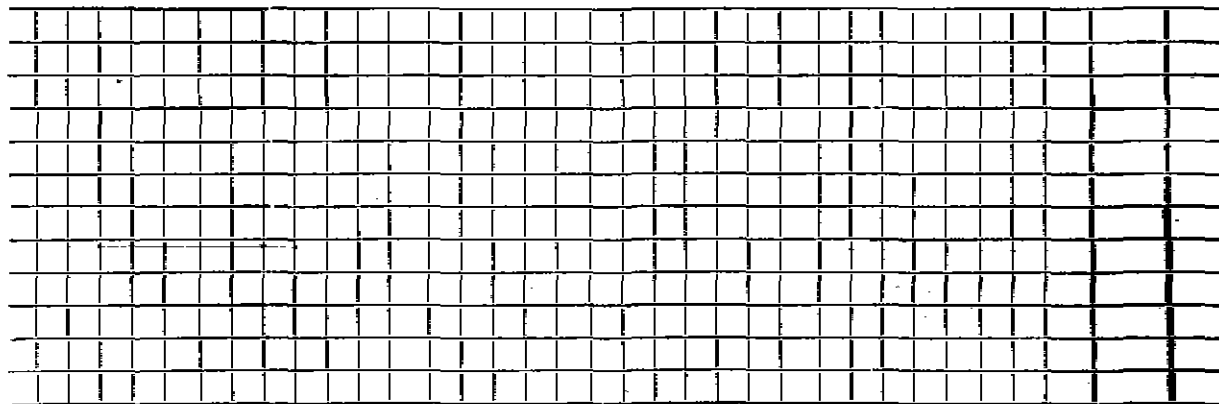

Connection made in ..... Street.

Work completed ..... 19..

Remarks: