

Name **Gifford Taylor**Service No. **29**Address **83 North Hancock Street****Lexington, Mass.**Location **83 N. Hancock St.**

Kind of Pipe

Size **6"**

Size of Main

~~XXXXXXXXXXXX~~ New ServiceCom. **June 27, 1949**

Location

Date	Material	Amount	Total	Date	Amount
May 19, '49	Labor	7 60		May 18 '49	Hydrated 150 00
May 23, '49	"	51 36	58 96	Jan 30 '49	Refunded 18 54
	10% Overhead		5 90		131 46
	70' - 6" Sewer Pipe @.27		18 90		
	Joint Compound		4 20		
	Littlefield Shovel 6 hrs. @7.00		42 00		
	Trucking 2 hrs. @.75		1 50		
			131 46		
	<b>Labor</b>				

**TOWN OF LEXINGTON—DEPT. OF PUBLIC WORKS**  
**SEWER DIVISION**

DATE .....

NO. ....


The undersigned applies for the construction of a particular sewer connecting No. ....  
Street and hereby agrees to comply with the Rules and Regulations governing the construction and use of Particular  
Sewers, as now or at any future time established by the Board of Selectmen.

Am't of estimate \$.....

Am't Paid \$.....

..... Owner

**Sketch of Service Here**

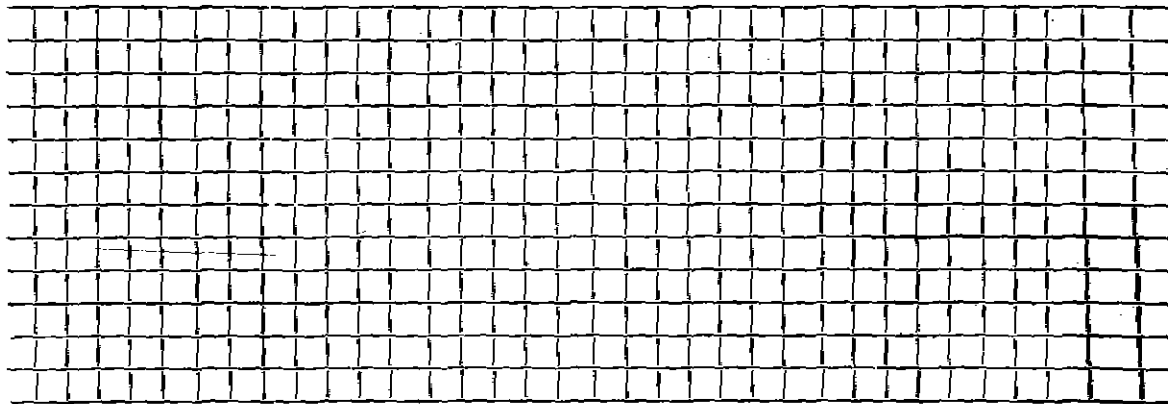

Connection made in ..... Street.

Work completed ..... 19..

Remarks: