

Name Lawrence E. Hunt

Service No. 25

Address 87 N. Hancock Street

Lexington, Mass.

Location 87 N. Hancock St.

Kind of Pipe

Size

Size of Main

~~XXXXXXXXXXXX~~ New Service

Com. June 27, 1949

Location

Date	Material	Amount	Total	Date	Amount
16, '49	Labor	63 35	63 35	May 11 '49	170 00
	10% Overhead		6 34	June 20 '49	51 12
	80' - 6" Sewer Pipe @.27		21 60		123 58
	1' - 6" 1/8 Bend		1 49		
	Joint Compound		4 80		
	Littlefield Shovel 3 1/2 hrs. @7.00		24 50	12-25-49	Service Blocked 45'
	Trucking 2 hrs. @.75		1 50		up from MH. The street
			123 58		can be flushed from
12-98	Repair made by house				street
	1" 5" 6" PVC				
	2 - 6x6 Clay to PVC Franks				
	Labor				

TOWN OF LEXINGTON—DEPT. OF PUBLIC WORKS
SEWER DIVISION

DATE

NO.


The undersigned applies for the construction of a particular sewer connecting No.
Street and hereby agrees to comply with the Rules and Regulations governing the construction and use of Particular
Sewers, as now or at any future time established by the Board of Selectmen.

Am't of estimate \$.....

Am't Paid \$.....

..... Owner

Sketch of Service Here

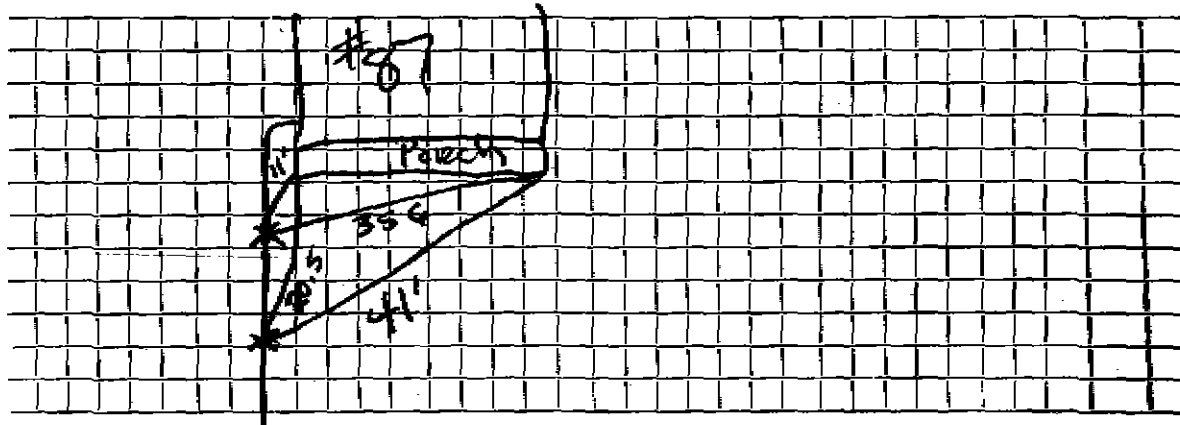

Connection made in Street.

Work completed 19..

Remarks: