


DATE _____

TOWN OF LEXINGTON — BOARD OF PUBLIC WORKS

SEWER DIVISION

Sketch of Service Here

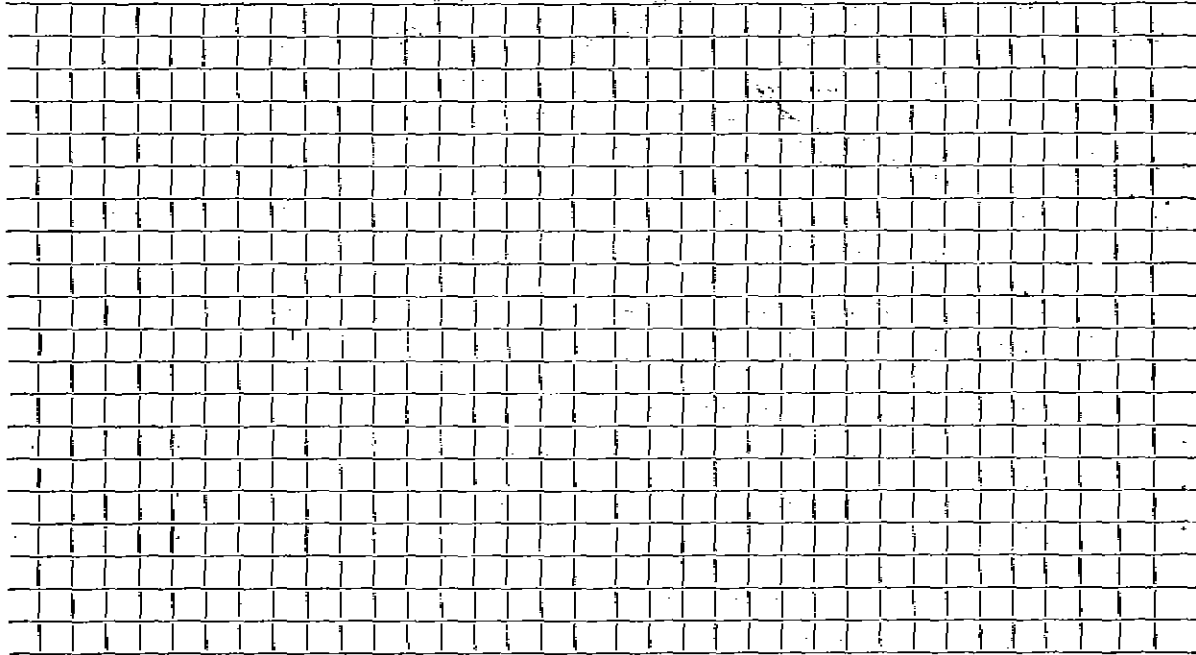

Connection made in Street. Work completed

Remarks: *Original Service 6-7-49 / (52'-6" Sewer Pipe, 1-6" Elbow)*