

Name **Roses E. Low**

Service No. **29**

Address **95 N. Hancock Street**

Lexington, Mass.

Location **95 North Hancock St.**

Kind of Pipe

Size

Size of Main

~~NEW SERVICE~~ New Service

Com. June 27, 1949

Location

Date	Material	Amount	Total	Date	Amount
18, '49	Labor	37 80		May 16 '49	125 00
19, '49	"	65 07	102 87	July 16 '49	10 95
	10% Overhead		10 29		135 95
	60' - 6" Sewer Pipe @.27		16 20		
	1 - 6" - 1/8 Bend		1 49	Bill sent 7-1-49	
	Joint Compound		3 60		
	Trucking 2 hrs. @.75		1 50		
			135 95		
	Labor				

TOWN OF LEXINGTON—DEPT. OF PUBLIC WORKS

SEWER DIVISION

DATE

NO.


The undersigned applies for the construction of a particular sewer connecting No.
Street and hereby agrees to comply with the Rules and Regulations governing the construction **and use of Particular**
Sewers, as now or at any future time established by the Board of Selectmen.

Am't of estimate \$.

Am't Paid \$.

..... Owner

Sketch of Service Here

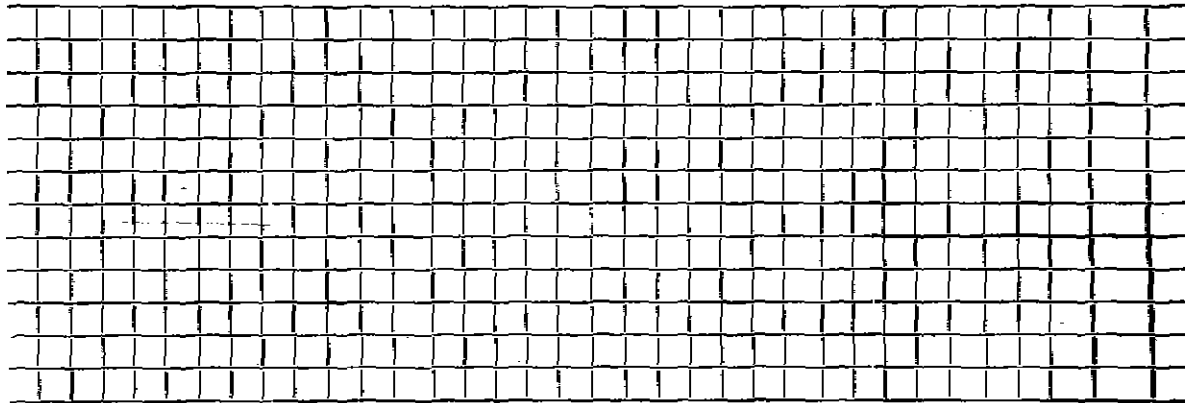

Connection made in Street.

Work completed 19..

Remarks: