

Name Moore Realty Trust

Service No. 17

Address 96 North Hancock Street

96 N. HANCOCK ST.

Location

Kind of Pipe

Size 6"

Size of Main

~~TRANSFERRED~~—New Service W.O. #7829


Location Comm 6-3-63

Date	Material	Amount	Total	Date	Amount	
4-24-63	Labor	37.04		4-9-63	Deposit	250.00
4-25-63	"	74.78	111.82	6-3-63	Paid by W.H.O.#18	9.68
	10% O.H.	11.18	123.00	6-3-63	" " #17	6.56
60'	6" Transite pipe @.82		49.20			266.24
1	90° Transite Elbow		4.09			
2	11½° Transite Elbows @2.35		4.70			
1	6" x 12" Nipple		5.75			
24	x 5 Patch		40.00			
3	hrs. Town Shovel @6.50		19.50			
4	hrs. Trucking @3.00		12.00			
1	hr. Trailer @3.00		3.00			
1	hr. Compressor @5.00		5.00			
			266.24			

DATE \_\_\_\_\_

**TOWN OF LEXINGTON — BOARD OF PUBLIC WORKS**  
**SEWER DIVISION**

Sketch of Service Here

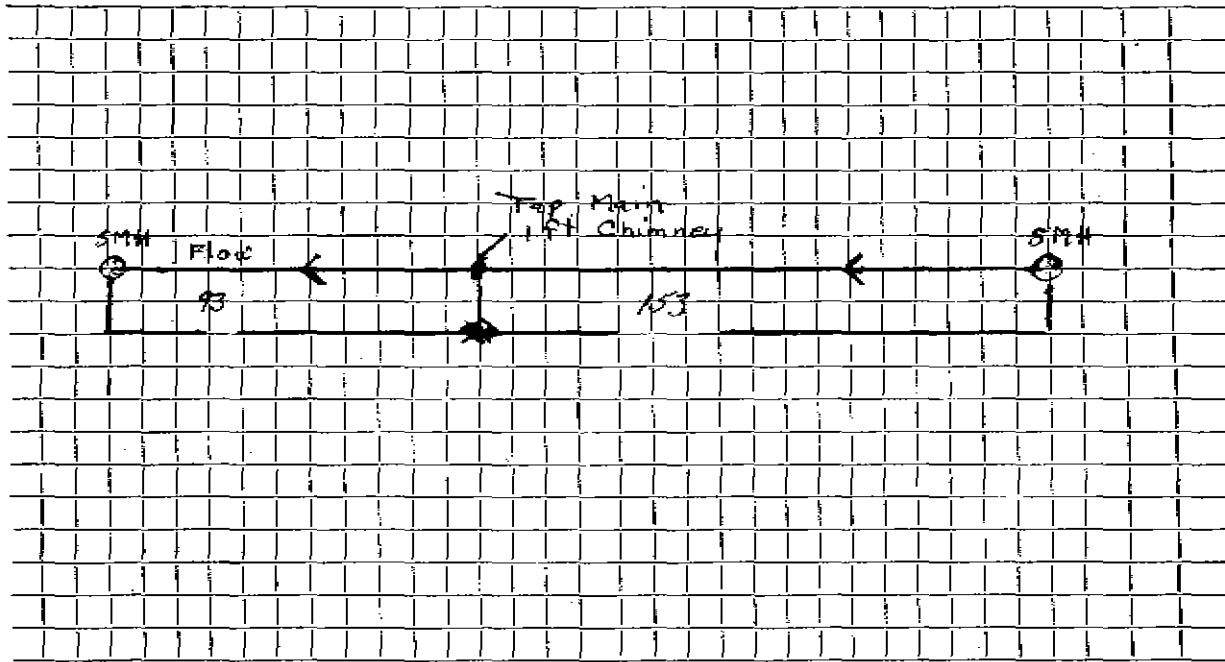

Connection made in ..... Street. Work completed .....

Remarks: .....

.....

.....