

Name **Bernard Maloney**Service No. **57**Address **99 No Hancock Street** *99 North Hancock St***99 N. Hancock St.**

Location

Kind of Pipe

Size **6"**

Size of Main

Repair—Renewal—New Service **Valeri Const. Co. #A279**Location **SEP 19 1966**


Date	Material	Amount	Total	Date	Amount
1/66	28' 6" Transite pipe			5-4-66	100 00
6/66	Labor 63.46			11-4-64	80 96
3/66	" 29.69	93.15			180 96
	10% O.H.	9.32	102.47		
	20' 6" Transite pipe @.82		16.40		
	1 11 1/2° Transite Bend		4.09		
	1 6 x 8 Service Saddle		5.25		
	1/2 bag cement		.75		
	1/2 ton Cold patch @5.50		2.75		
	2 1/2 ton Hot Top		13.75		
	3 1/2 ton Trucking @3.00		10.50		
	2 hrs. Town Shovel @6.50		13.00		
	1/2 hr Front Loader		2.00		
	1 hr. Compressor		5.00		
	1 hr. Roller		3.00		
	1 hr. Trailer		2.00		
			180.96		Bill sent 80 96

DATE \_\_\_\_\_

TOWN OF LEXINGTON — BOARD OF PUBLIC WORKS

SEWER DIVISION

Sketch of Service Here **99**

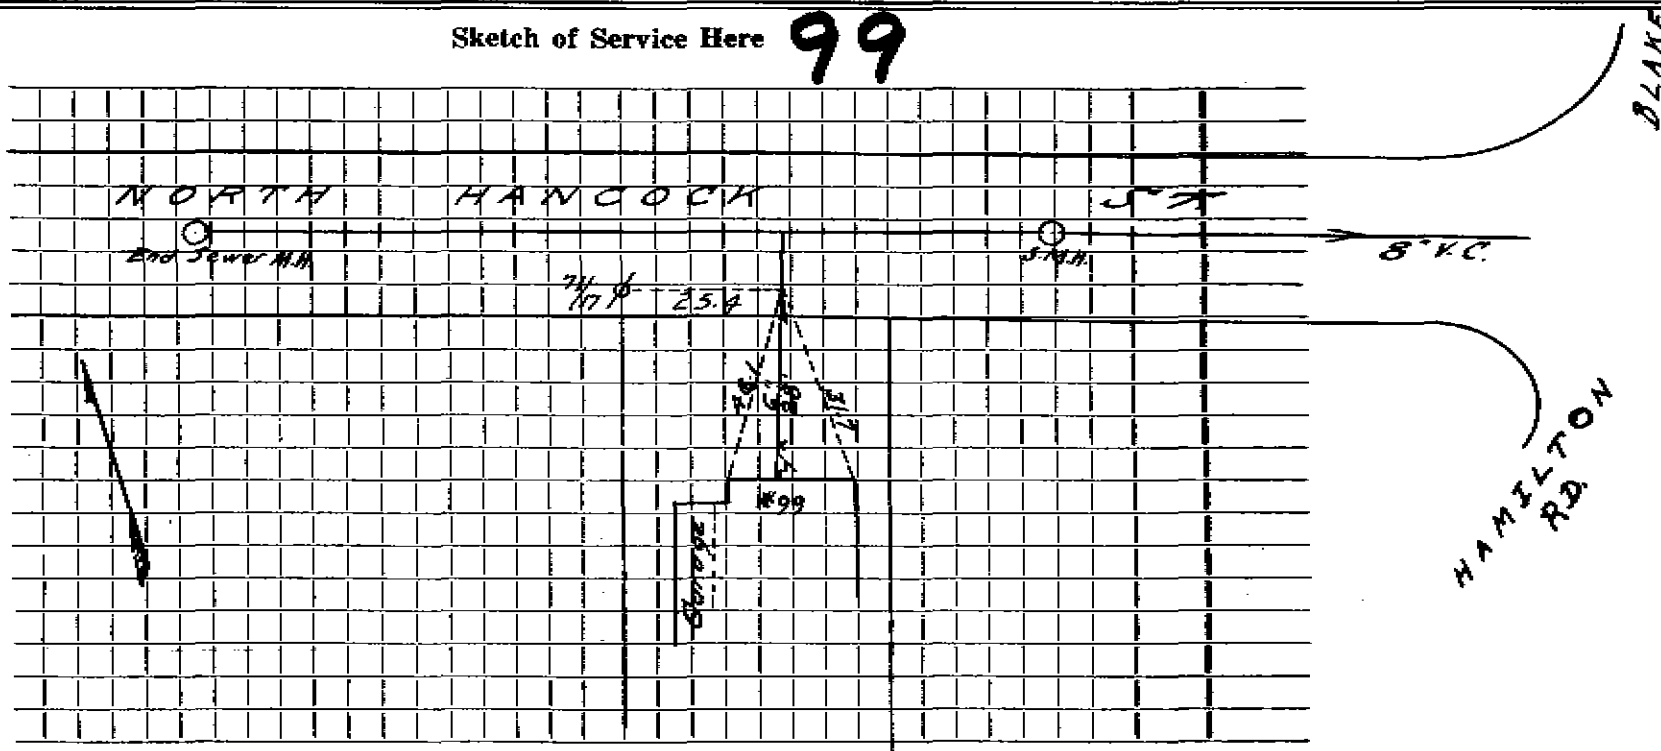

Connection made in ..... Street. Work completed .....

Remarks: .....

.....