

Name

Service No.

Address

172 NORTH ST

TAYLOR EXCAVATION

Location

Kind of Pipe

Size

Size of Main

Repair—~~Renewal~~—New Service

Location

Date

Material

Amount

Total

Date

Amount

7/11/14

6" SDR

4" CLEAN OUT
1/2" PVC CAP
1/2" SDR RISER
1/2" TEE W/1/2"

11" DENO


6" x 6" FRAMES

DATE 7/10/12

TOWN OF LEXINGTON — BOARD OF PUBLIC WORKS

SEWER DIVISION

Sketch of Service Here

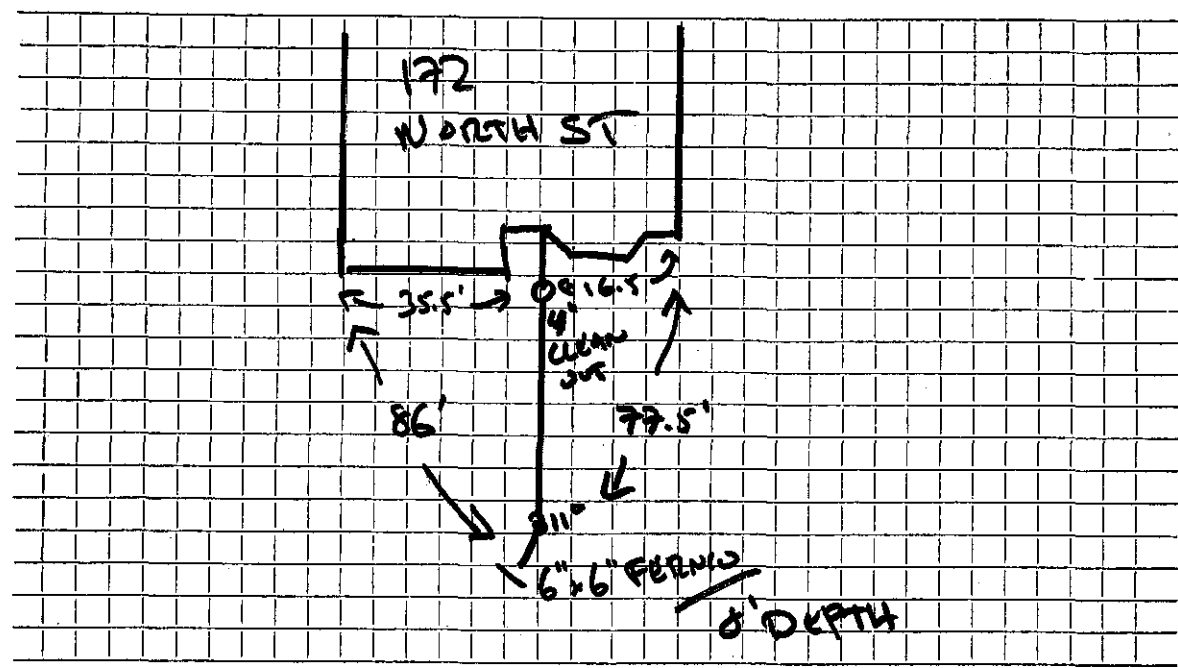

Connection made in NORTH Street. Work completed TAYLOR EXCAVATION

Remarks:

.....

.....