

Name John Martie

Service No. 62

Address 104 North Street

104 North St.

Location Lot #18A

Kind of Pipe

Size 6"

Size of Main 8"

Repair—Renewal—New Service Eagle #1627


Location JUL 27 1970

Date	Material	Amount	Total	Date	Amount
ac 1969	20' 6" transite pipe @ 8.00	-	\$ 160 00	7-16-70	160 00
-16-70	100' 6" Transite pipe				
	2' 4" Cast Iron pipe			12- - 69	
				20' 6" Transite	
				1 6" X 8" Wye	

DATE _____

TOWN OF LEXINGTON — BOARD OF PUBLIC WORKS

SEWER DIVISION

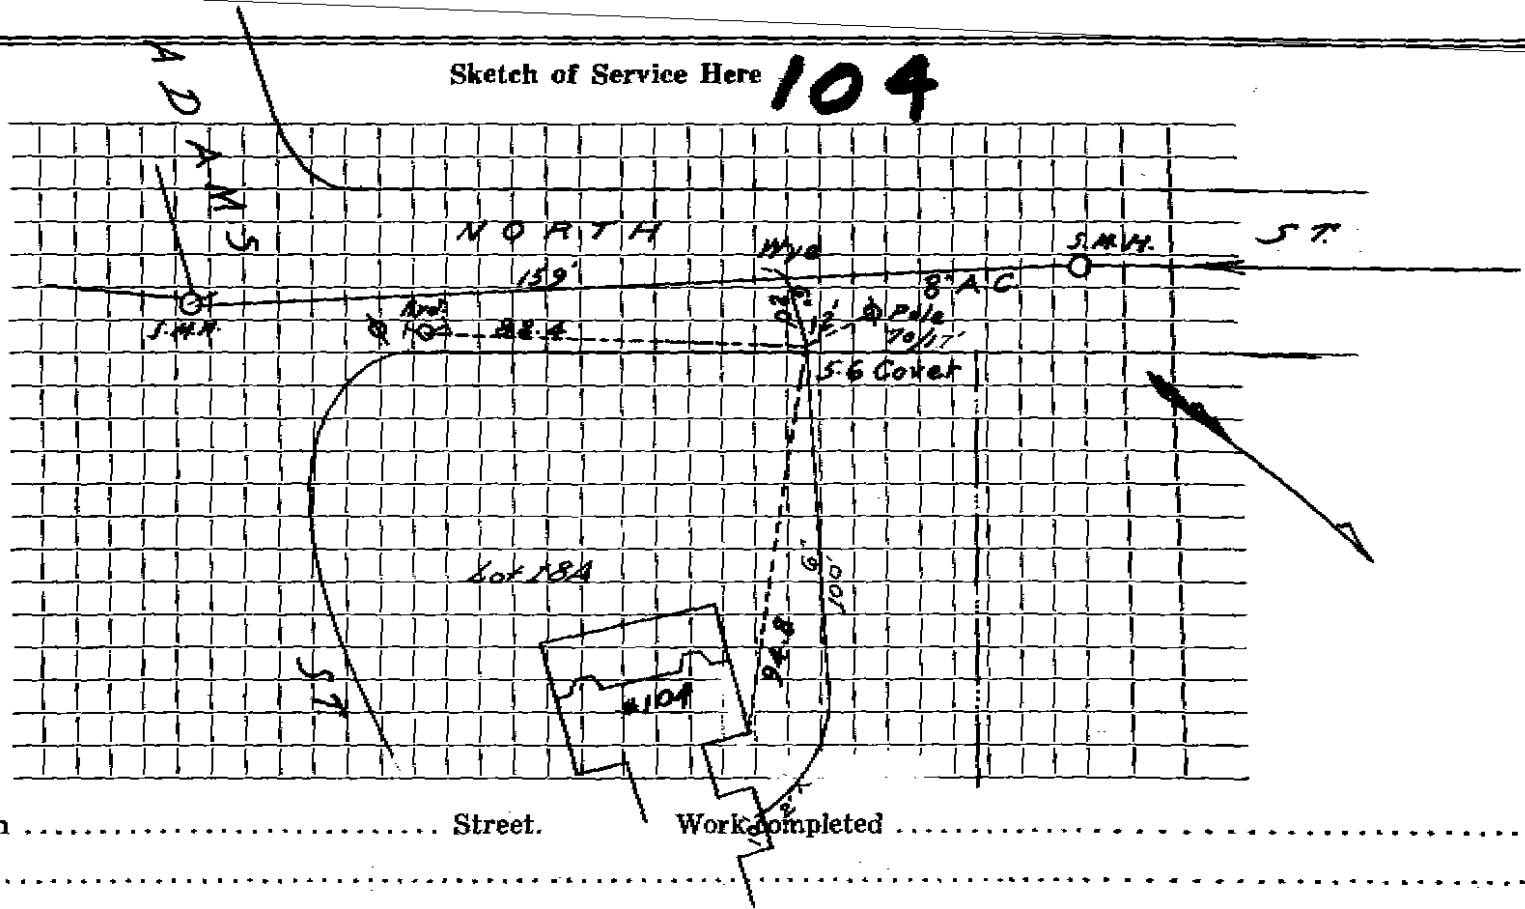

Connection made in Street. Work completed

Remarks:

.....

.....