

Name John MacLeod

Service No. 20

Address 11 North Street

Lot 2

11 North St.

Location

Kind of Pipe

Size 6"

Size of Main 8"

Repair—Renewal—New Service Valeri #1336

Location MAY 27 1969


Date	Material	Amount	Total	Date	Amount
<del>5-16-68</del>	<del>12' 6" Transite pipe @ \$8.00</del>		96.00	5-2-69	Deposit 96.00
5-8-69	89' 6" Transite pipe			9-	
	10' 12" Cast Iron pipe			- 68	
					12' 6" Transite
					1 6" X 8" Wye

DATE \_\_\_\_\_

TOWN OF LEXINGTON — BOARD OF PUBLIC WORKS

SEWER DIVISION

Sketch of Service Here //

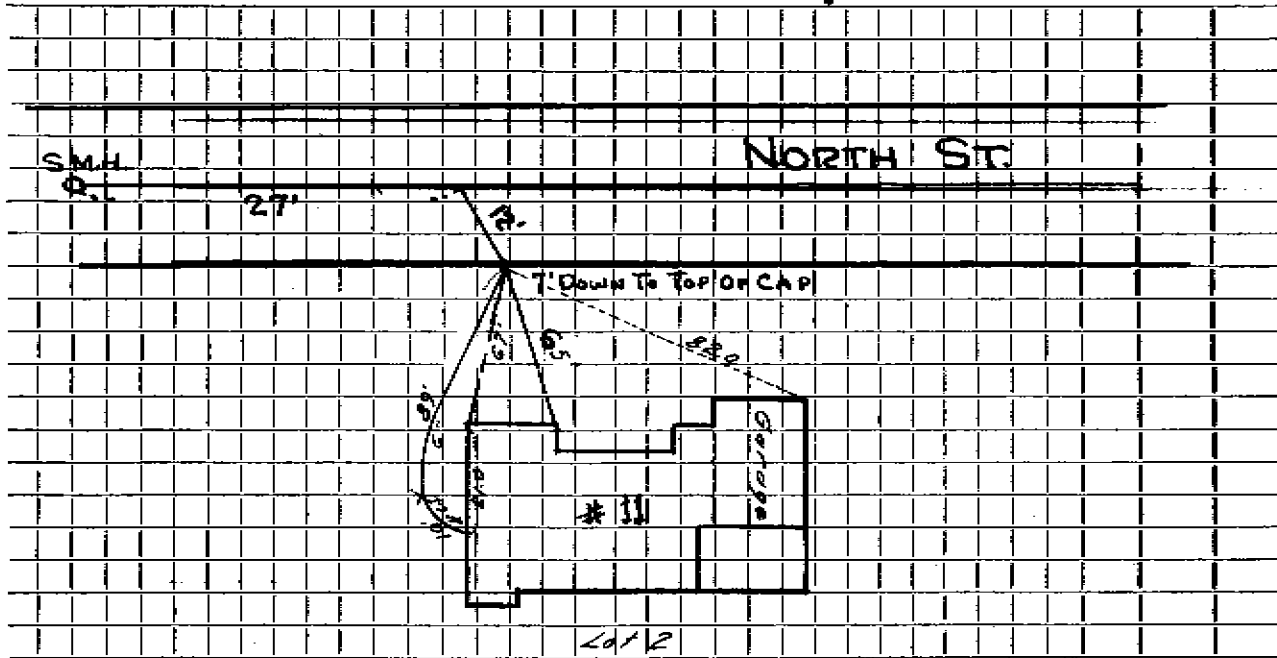

Connection made in ..... Street. Work completed .....

Remarks: .....

.....

.....