

Name Alden L. Webster

Service No. 130

Address ~~113 North ST.~~

JUN 18 1973

113 North ST.

Location

Kind of Pipe

Size 6" A.C.

Size of Main

6" A.C.

~~Repair~~ New Service

Devine #2203


Location

Date	Material	Amount	Total	Date	Amount
9-12-72	11' 6" A.C. @ 9.00	99.00		9-14-72	99.00
				9-12-72	
					Deposit
					11' 6" Transite
					1 6" x 8" Wye

DATE _____

TOWN OF LEXINGTON — BOARD OF PUBLIC WORKS
SEWER DIVISION

Sketch of Service Here

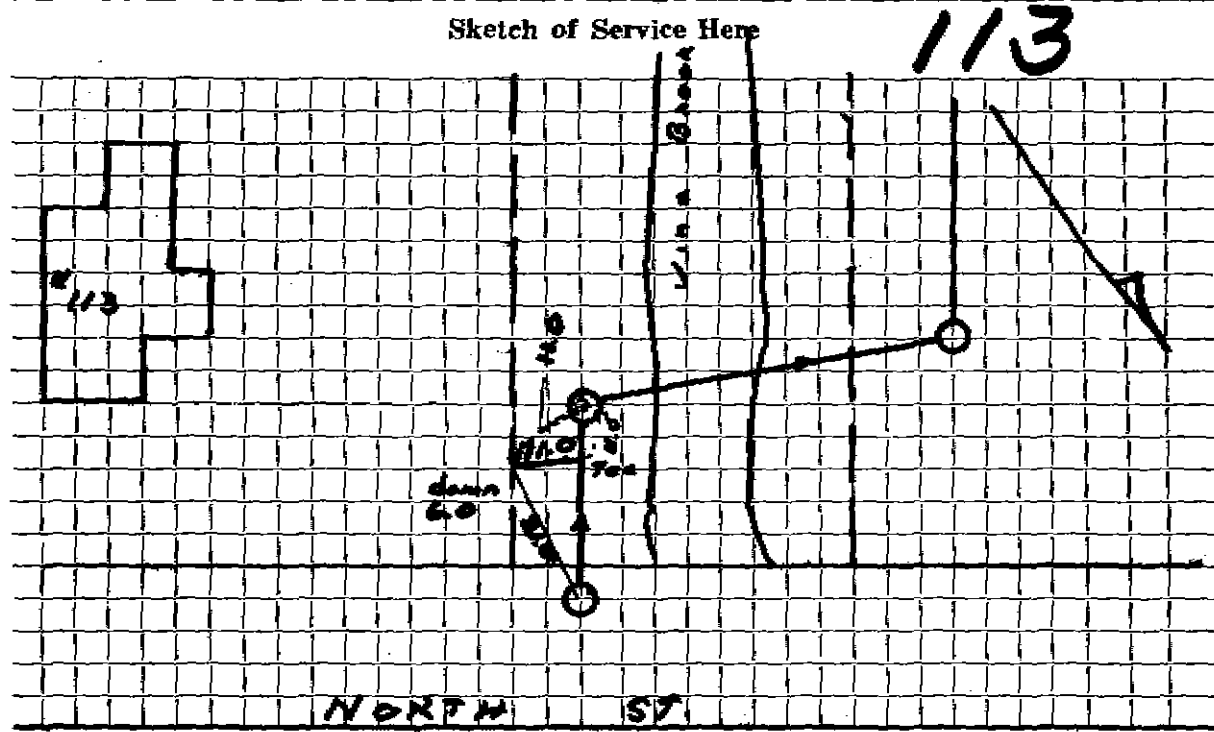

Connection made in Street. Work completed

Remarks:

.....

.....