

Name Henry A. Johnson

Service No. 113

Address 13 North Street

Lot 1

13 North ST.

Location

Kind of Pipe

Size 6"

Size of Main 8"

Repair — Renewal — New Service Valeri #1315

Location MAY 27 1969

Date	Material	Amount	Total	Date	Amount
1-16-68	23'	6" Transite pipe @ 8.00	184.00	11-4-68	184.00
4-23-69	45'	6" Transite pipe			
	10'	4" Cast Iron pipe		9- -68	
					23' 6" Transite
					1 6" X 8" Wye



13 north

DATE _____

TOWN OF LEXINGTON — BOARD OF PUBLIC WORKS

SEWER DIVISION

Sketch of Service Here **13**

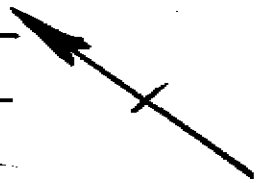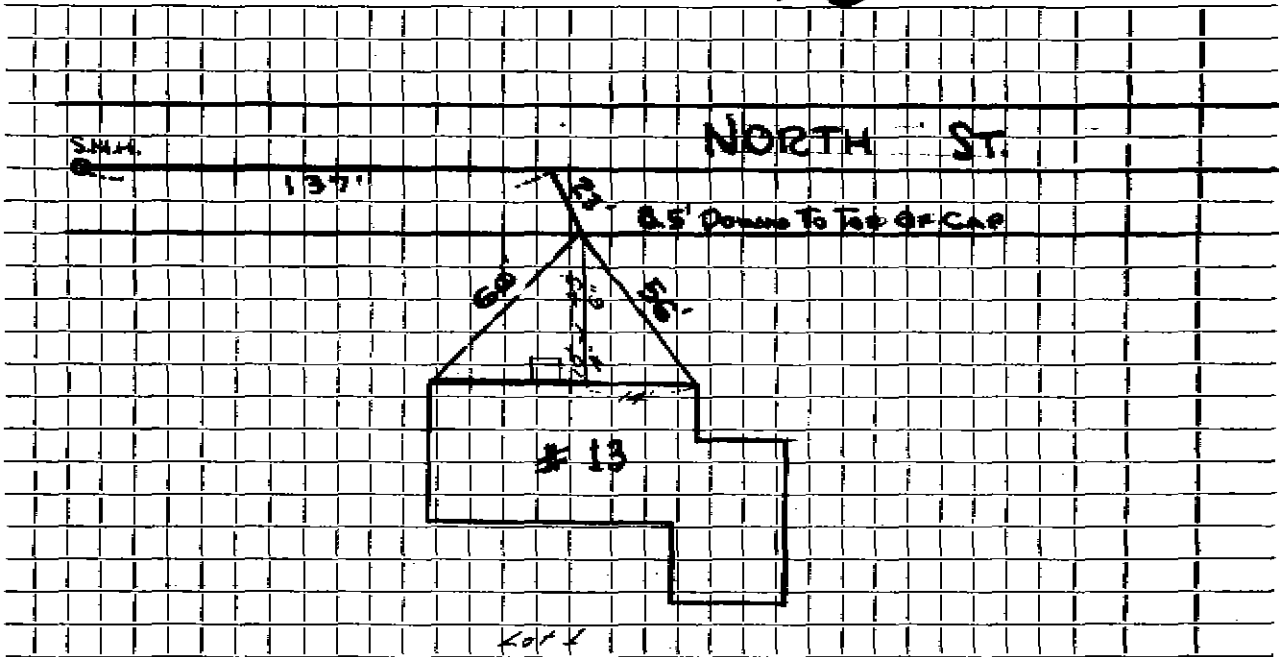

Connection made in Street. Work completed

Remarks:

.....

.....