



DATE Dec 1980


TOWN OF LEXINGTON - BOARD OF PUBLIC WORKS

SEWER DIVISION

130

Sketch of Service Here

#130 NORTH ST

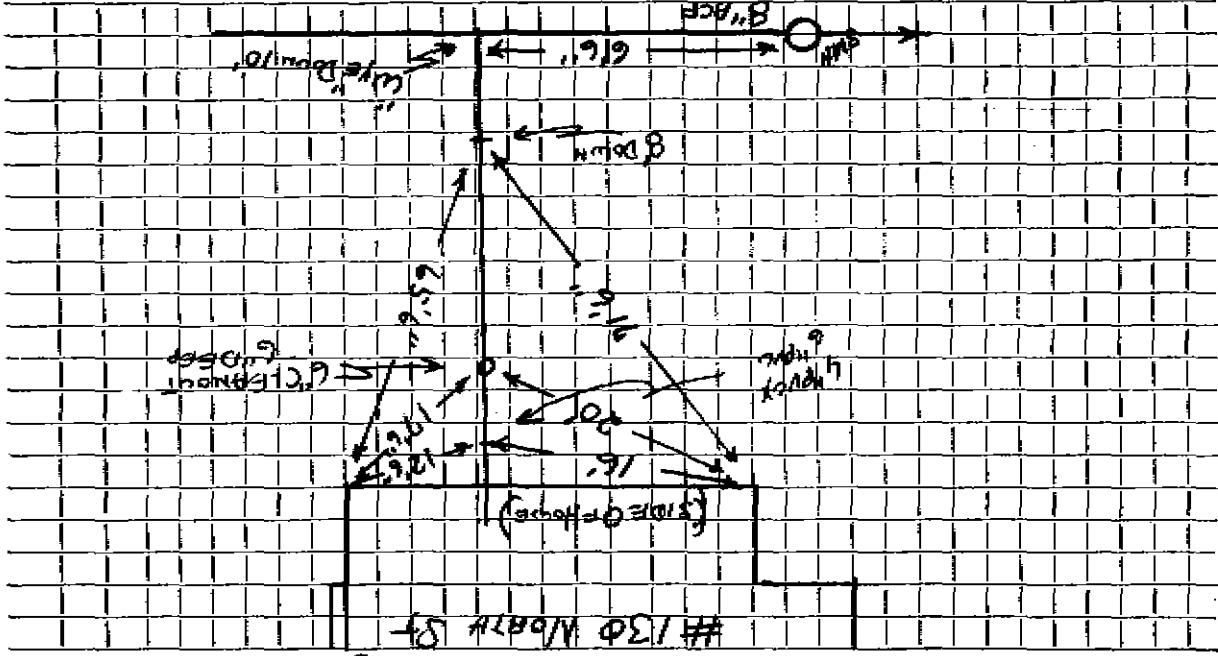

Connection made in NORTH ST Street. Work completed June 11, 1984

Remarks: