




DATE \_\_\_\_\_

TOWN OF LEXINGTON — BOARD OF PUBLIC WORKS  
SEWER DIVISION

**134** Sketch of Service Here

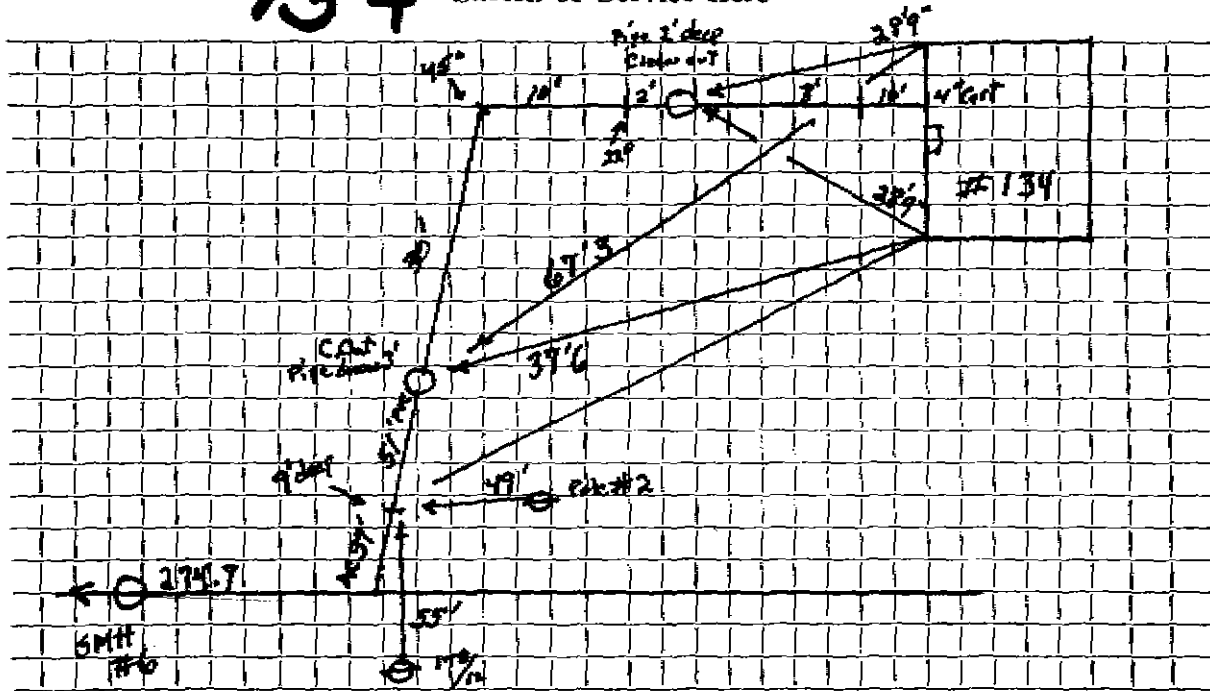

Connection made in ..... Street. Work completed .....

Remarks: *Iron rod at Clean Outs for detection*