

Name James Manjanello

Service No. 47

Address #153 NORTH ST.

153 North ST.

Location

Kind of Pipe *Dep*

Size *6"*

Size of Main *8"*

~~IMPACT RESISTANT~~ New Service G.I. Nicoloi Co. #4951


Location

Date	Material	Amount	Total	Date	Amount
AUG/00	28' of 6" Dep @	14.00/ft	= 392.00	11-13-87	Deposit 392.00
11/13/87	75' 6" 6" PVC			8- - 80	
	9' 4" Cast Iron			28' 6" Transite	
	6 x 6 Fernox				
	4 x 6 Fernox				
	1 6" 22° Bend				
	1 6" Nye C.O.				
	1 3' 8" Riser				

TOWN OF LEXINGTON — BOARD OF PUBLIC WORKS

SEWER DIVISION

153 Sketch of Service Here

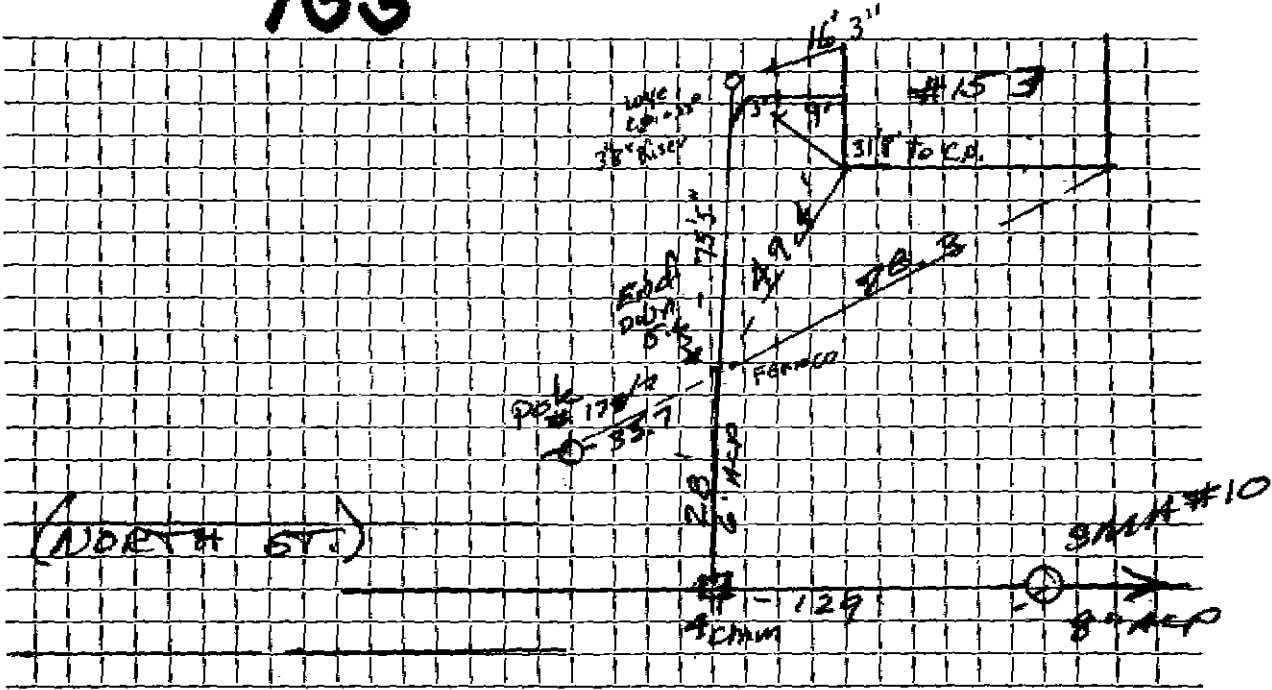

Connection made in NORTH ST. Street. Work completed

Remarks: