

Name Arthur Williams

Service No. 108

Address 16 North Street

Pt. 13 & Pt. 14

16 North St.

Location

Kind of Pipe

Size 6"

Size of Main 8"

Repair—Renewal—New Service

Suburbanite #1222

Location JAN 27 1969


Date	Material	Amount	Total	Date		Amount
168	13' 6" Transite pipe @8.00		104.00	11-28-68	Deposit	104.00
-19-68	76' 6" Transite pipe					
	10' 4" Cast Iron pipe			9- -68		
					13' 6" Transite	
					1 6" X 8" Wye	

DATE _____

TOWN OF LEXINGTON — BOARD OF PUBLIC WORKS

SEWER DIVISION

Sketch of Service Here **16**

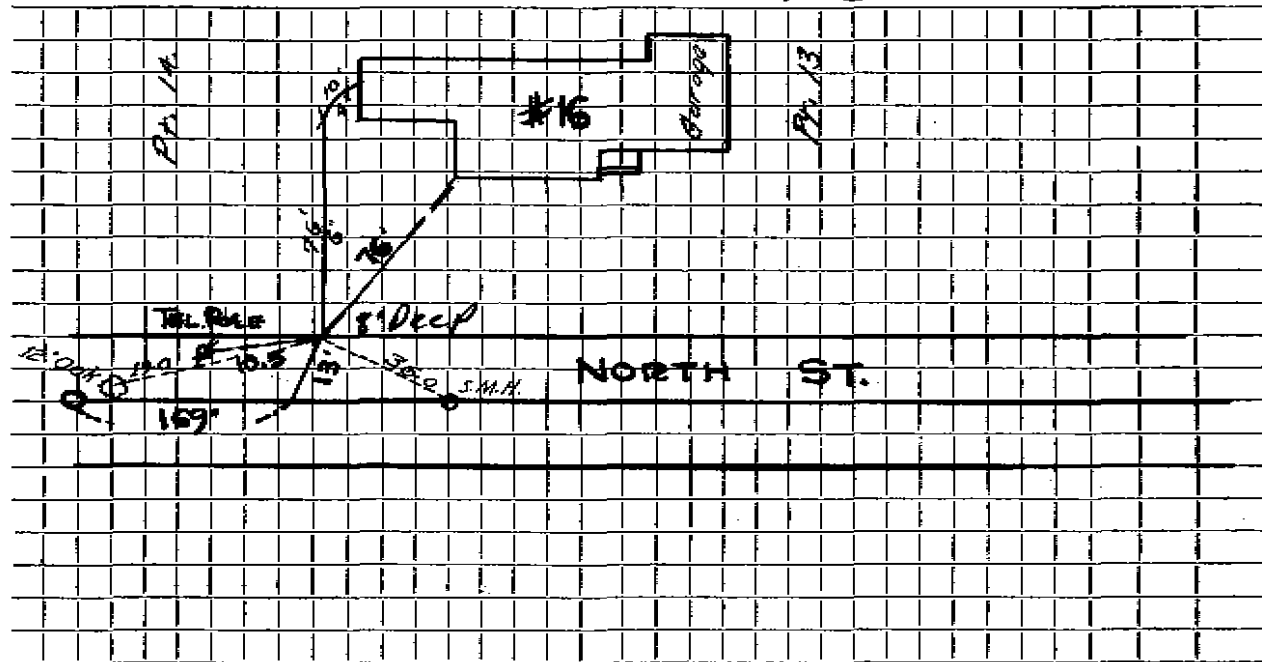

Connection made in Street. Work completed

Remarks:
.....
.....