


SEWER DIVISION

Sketch of Service Here
160

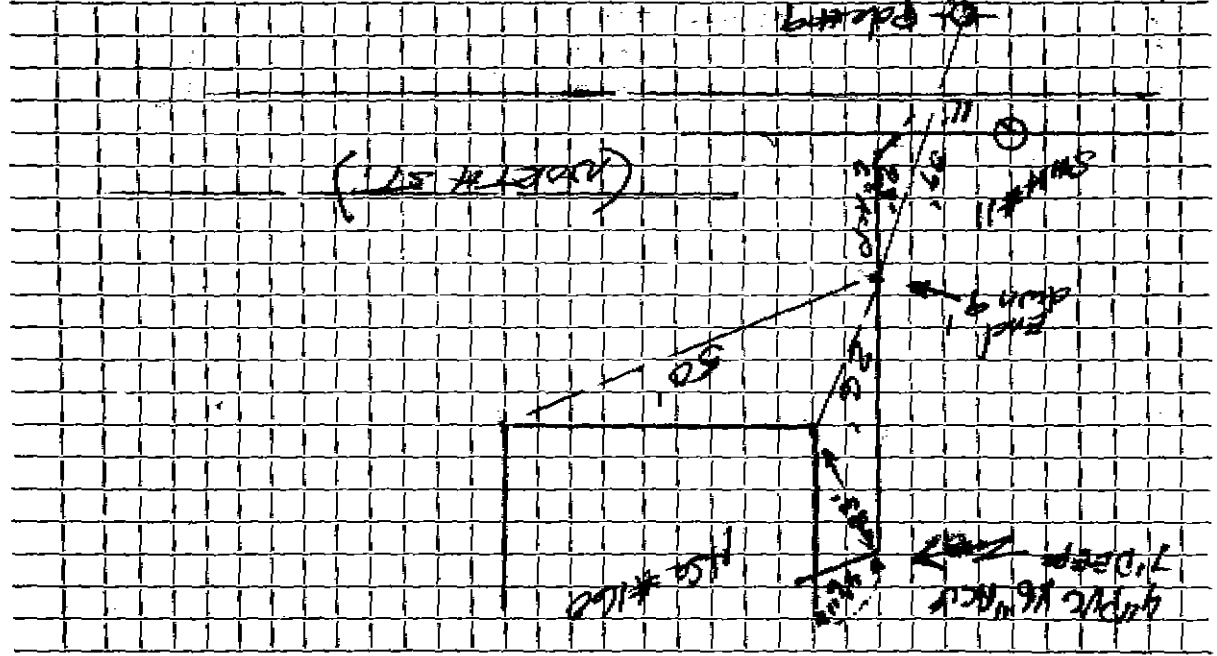

Connection made in _____ Street.

Work completed _____

Remarks: _____