

Name Address

Service No.

Location

Kind of Pipe

Repair—Removal—New Service

Location

Size of Main

Date	Material	Amount	Total	Date	Amount
3/27/86	19' 6" PVC 1 - 6" 22° Bend cctle PUC to AC flanges	\$ - 80	20'	6"	Tennistex 6x8 wye


Remarks:

Connection made in

→ find S! ~~out of pocket~~
part 39 of ~~transac~~

272 The G. S. Street.

Work completed

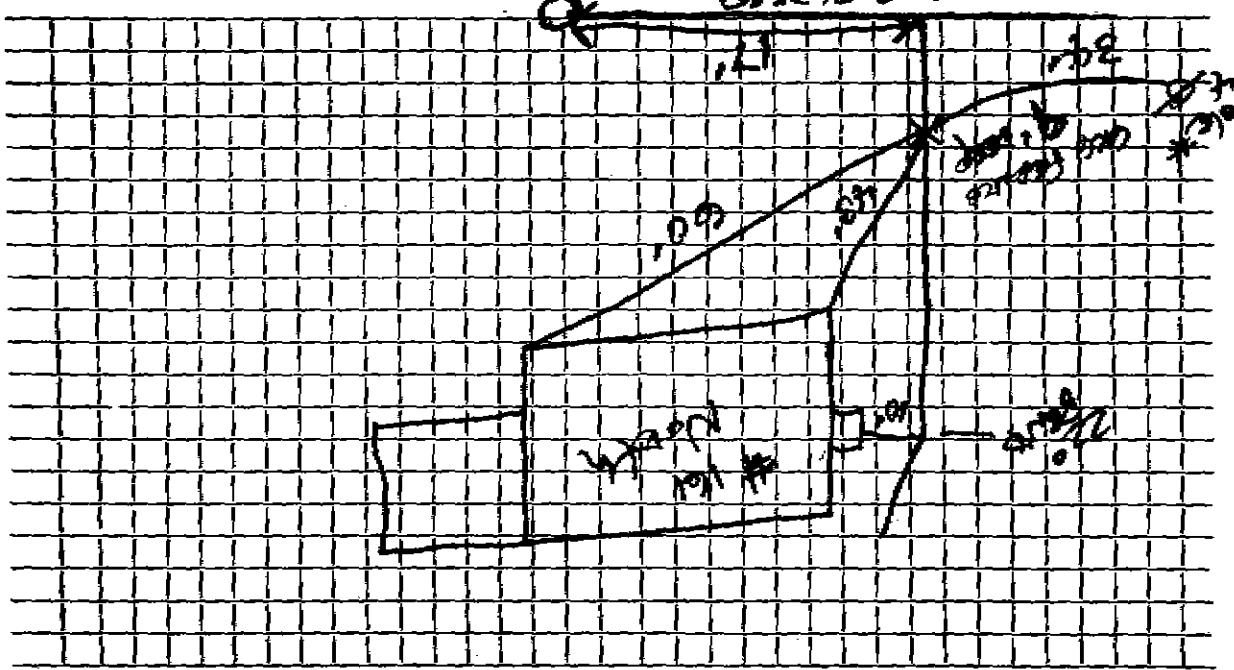

Sketch of Service Here

SEWER DIVISION

TOWN OF LEXINGTON — BOARD OF PUBLIC WORKS

-319-