


TOWN OF BEXINGTON BOARD OF PUBLIC WORKS

DATE _____

SEWER DIVISION

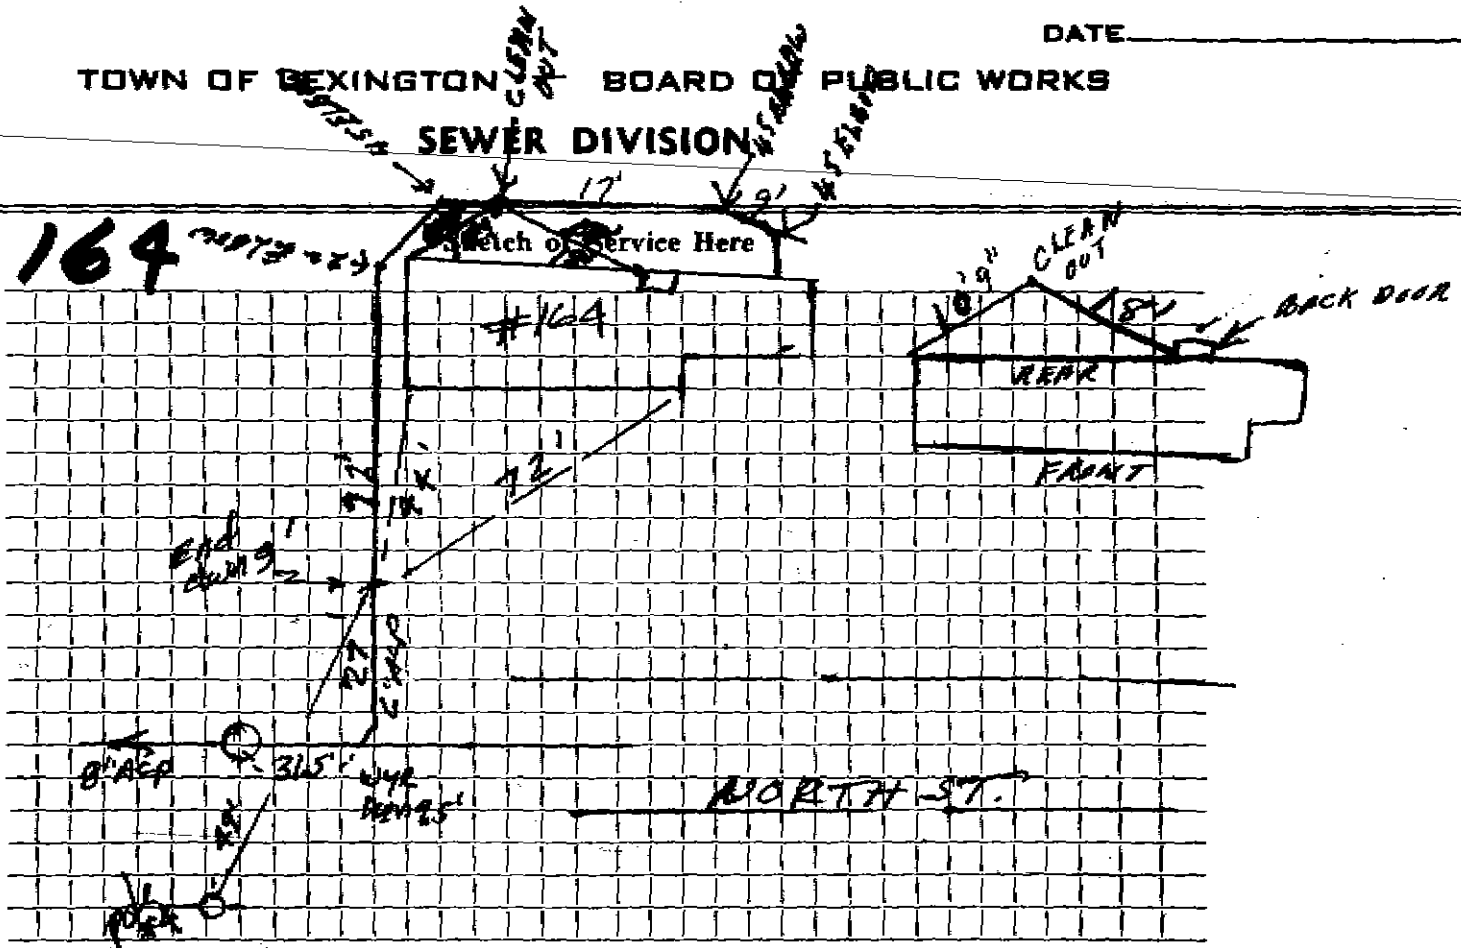

Connection made in NORTH ST. Street. Work completed

Remarks: