

11/28/86 DS. # 864 70 300

Name **Barbara Barrons**

Service No. **6**

Address **#168 NORTH ST.**

168 North ST.

Location

Kind of Pipe **ACP**

Size **6"**

Size of Main **8"**

~~Repair~~ ~~Renewal~~ ~~XXXXXX~~ **New Service** Suburbanite #4377


Location

Date	Material	Amount	Total	Date	Amount
				12-1-86	350.00
				Deposit	00
Aug/80	25' of 6" ACP	14.00/ft =	350.00	8- - 80	
12/12/86	89' 6" PVC			25'	6" Transite
	22° Coup.			1	6" x 8" Wye
	6 x 6 PVC to AC Fernco				
	2 45° Coup.				
	45° Sweep				
	4 x 6 Fernco				
	2' 6" of 4" CI				
	45° 4" Elbow C.I.				
	2 No Hub Clamps Stainless				

DATE _____

TOWN OF LEXINGTON — BOARD OF PUBLIC WORKS

SEWER DIVISION

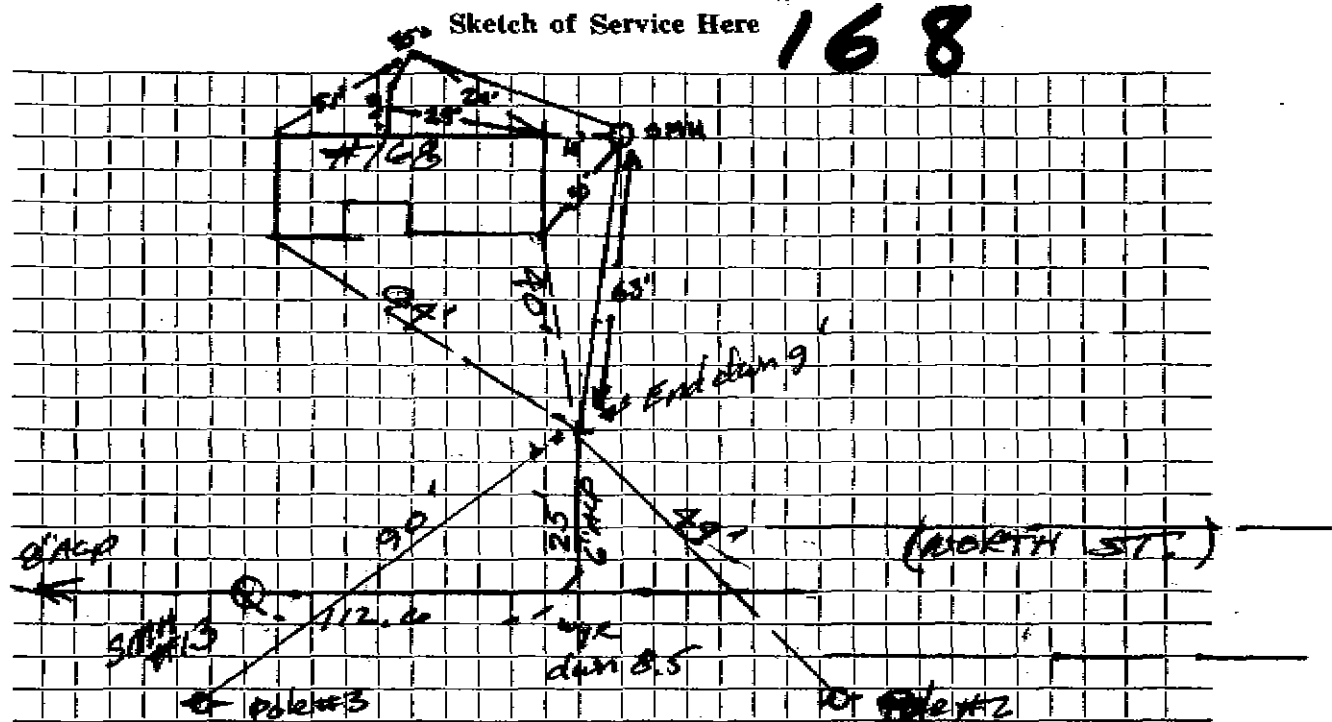

Connection made in NORTH Street. Work completed

Remarks:

.....

.....