

Name

Aldo Gallinelli

Service No.

Address

169 NORTH ST.

Location

Kind of Pipe

Size of Main 8" ACP

Repair—Renewal—New Service

Location

Paolini Corp. 7/28/88 #4661

Size

Date

Material

Amount

Total

Date

Amount

~~8/4 88~~

~~20' 6" ACP C~~

~~14.00/ft~~

~~= \$392.00~~

~~7-28-88~~

~~392.00~~


8-11-88

28' 6" Transite
1 6" x 8" Wye

DATE 8/4/88

TOWN OF LEXINGTON — BOARD OF PUBLIC WORKS
SEWER DIVISION

Sketch of Service Here 169

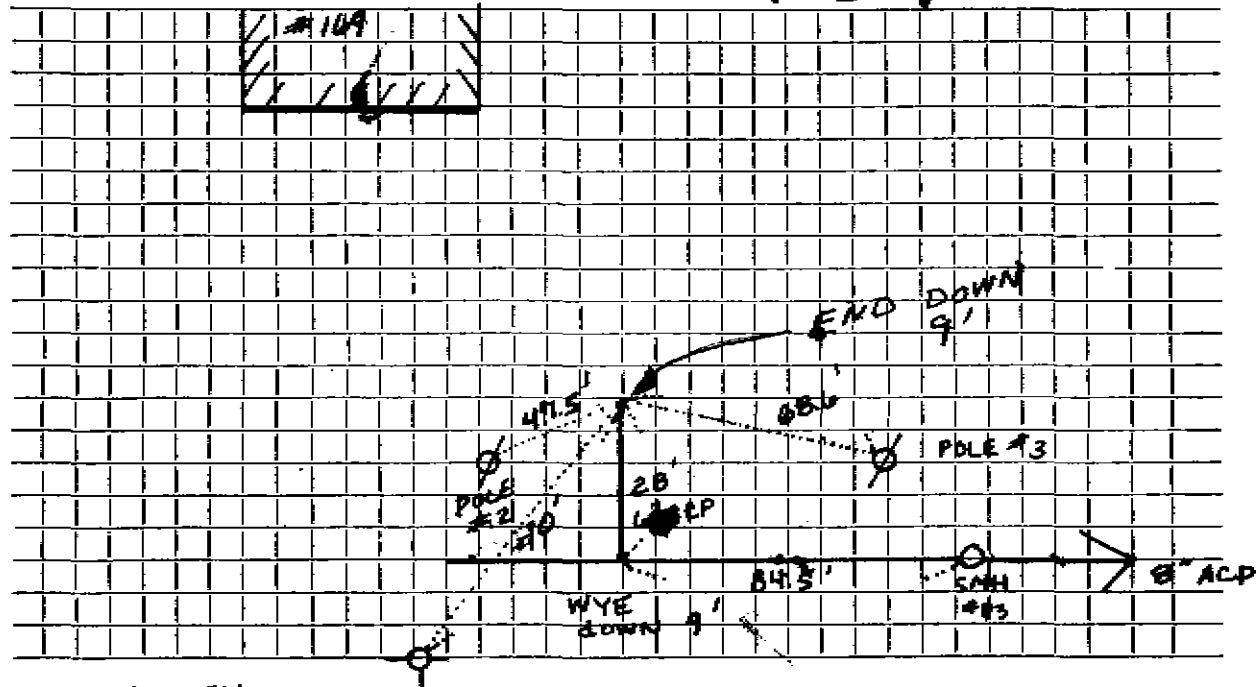

Connection made in NORTH Street. Work completed

Remarks: NO INSIDE TIES INSP. PEV