

Name Jonah Kalb

Service No. 111

Address 17 North Street

17 North St.

Location

Kind of Pipe

Size 6"

Size of Main 8"

Repair—Renewal—New Service

Suburbanite #1245


Location JAN 27 1969

Date	Material	Amount	Total	Date	Amount
<del>1-168</del>	<del>16'</del>	<del>6" Transite pipe</del>	<del>@8.00</del>	<del>11-1-68</del>	<del>128.00</del>
<del>-6-68</del>	<del>67'</del>	<del>6" Transite pipe</del>			
	<del>5'</del>	<del>4" Cast Iron pipe</del>			
				<u>9- - 68</u>	
				<u>16' 6" TRANSITE</u>	
				<u>1 6" X 8" Wye</u>	

# TOWN OF LEXINGTON — BOARD OF PUBLIC WORKS SEWER DIVISION

Sketch of Service Here

17

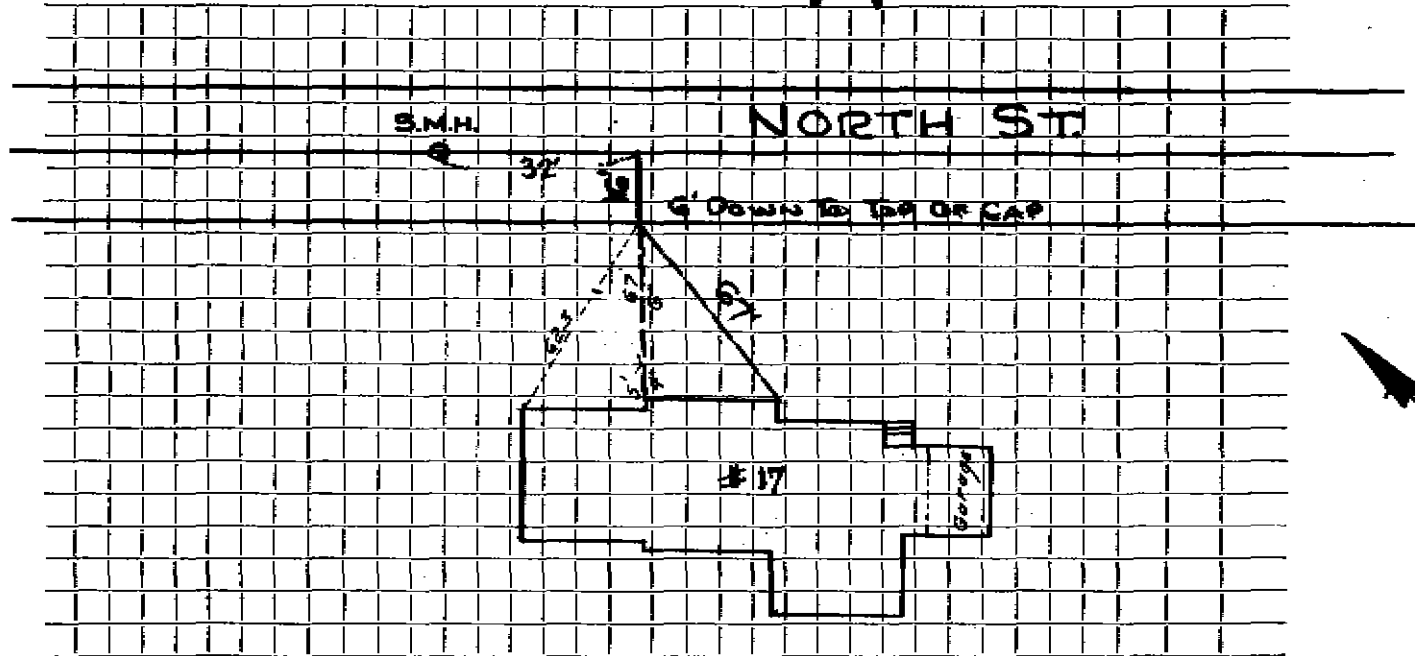

Connection made in ..... Street. Work completed .....

Remarks: .....

.....

.....