

Name

Service No.

Address 19 North Street

19 North St

Location

Kind of Pipe

Size 6"

Size of Main 8"

Repair—Renewal—New Service

Location

Date		Material	Amount	Total	Date		Amount
p '68	18'	6" Transite pipe @8.00		144.00			
					9- -68		
					18' 6" Transite		
					1 6" X 8" Wye		
					8-28-98	48' 6" PVC	
						6" WYE clean out	


DATE \_\_\_\_\_

TOWN OF LEXINGTON — BOARD OF PUBLIC WORKS

SEWER DIVISION

Sketch of Service Here

19

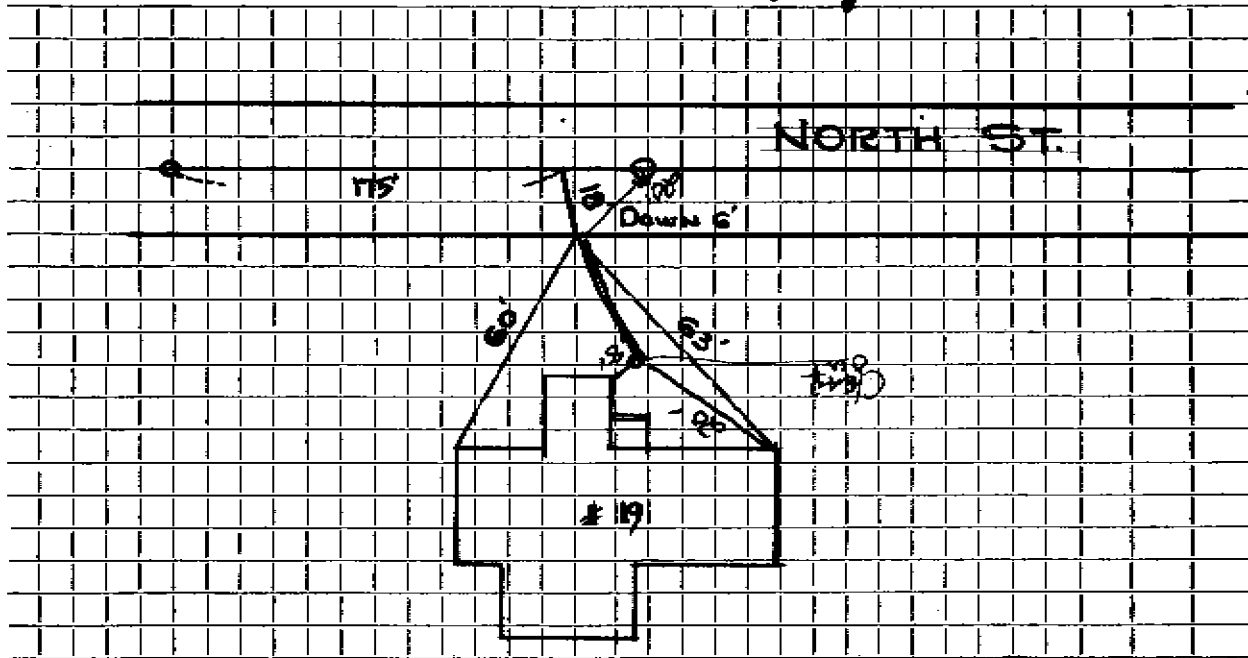

Connection made in ..... Street. Work completed .....

Remarks: .....

.....

.....