

Name Gordon Peterson

Service No. 19

Address 2 North Street

Pt. Lot 18

2 North ST.

Location

Kind of Pipe

Size 6"

Size of Main 8"

Repair—Renewal—New Service Valeri #1326


Location MAY 27 1969

Date		Material	Amount	Total	Date		Amount
sep 168	17	6" Transite pipe	@8.00	136.00	4-29-69		136 00
-2-69	43'	6" Transite pipe					
	10'	4" Cast Iron pipe			9- - 68		
						17 6" Transite	
						1 6" X 8" Wye	

TOWN OF LEXINGTON — BOARD OF PUBLIC WORKS

SEWER DIVISION

Sketch of Service Here **2**

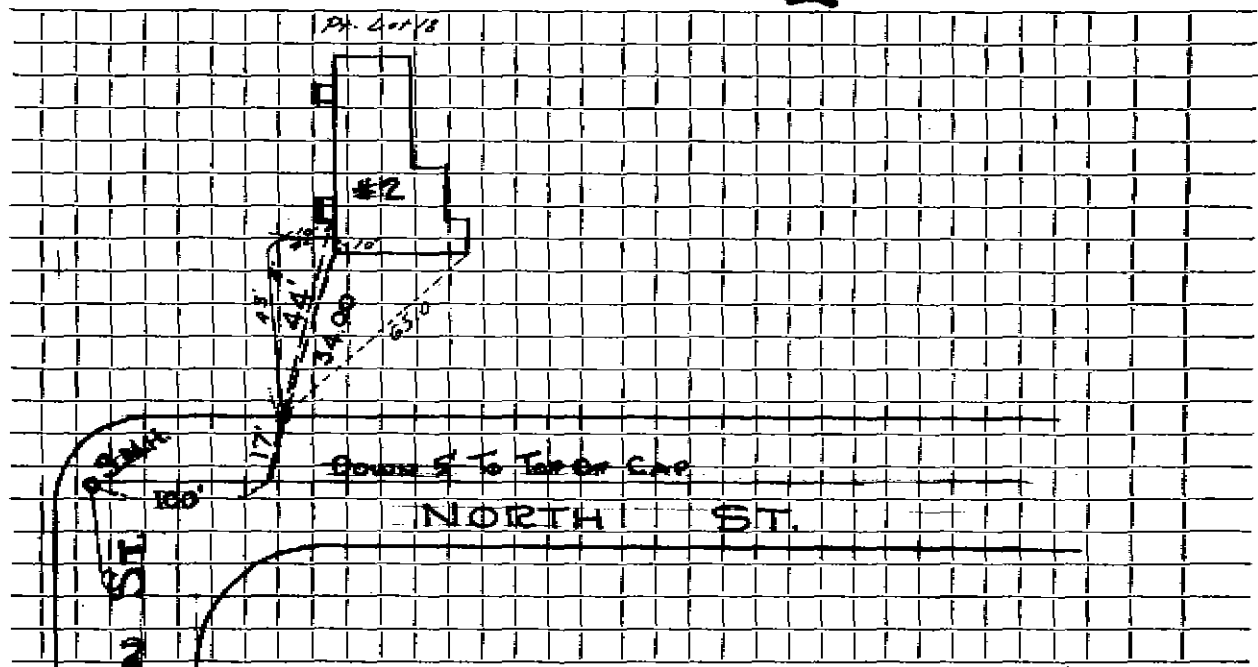

Connection made in Street. Work completed

Remarks:
.....
.....