

Name

Service No.

Address

20 Nor Th St.

Location

Kind of Pipe

Size 6"

Size of Main 8"

Repair—Renewal—New Service

Location

Date	Material	Amount	Total	Date	Amount
1-1-68					
87'	6" TRANSITE				
5'	4" C.I. PIPE			9- -68	
				15' 6" TRANSITE	
				1 6" X 8" WYE	


DATE \_\_\_\_\_

TOWN OF LEXINGTON — BOARD OF PUBLIC WORKS

SEWER DIVISION

Sketch of Service Here

20

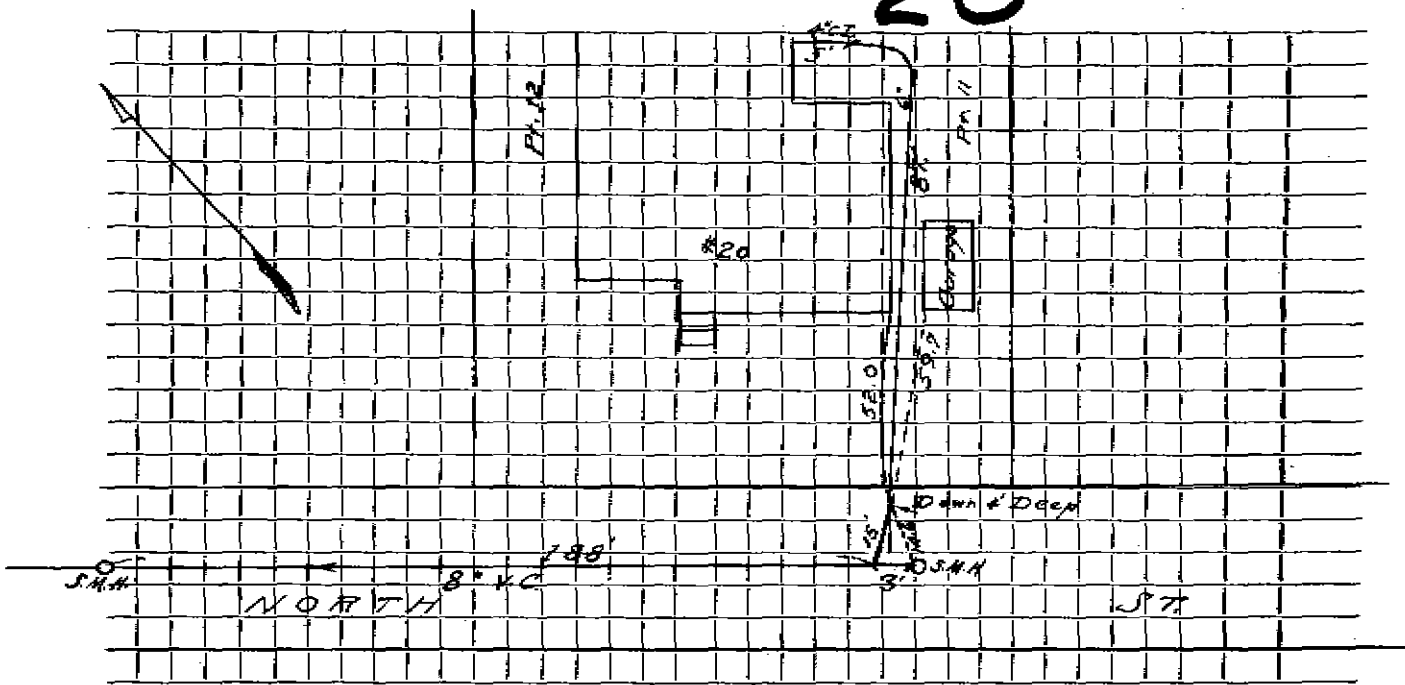

Connection made in ..... Street. Work completed .....

Remarks: .....

.....

.....