


DATE 10/28/83

TOWN OF LEXINGTON — BOARD OF PUBLIC WORKS
SEWER DIVISION

J. [Signature]

Sketch of Service Here **21**

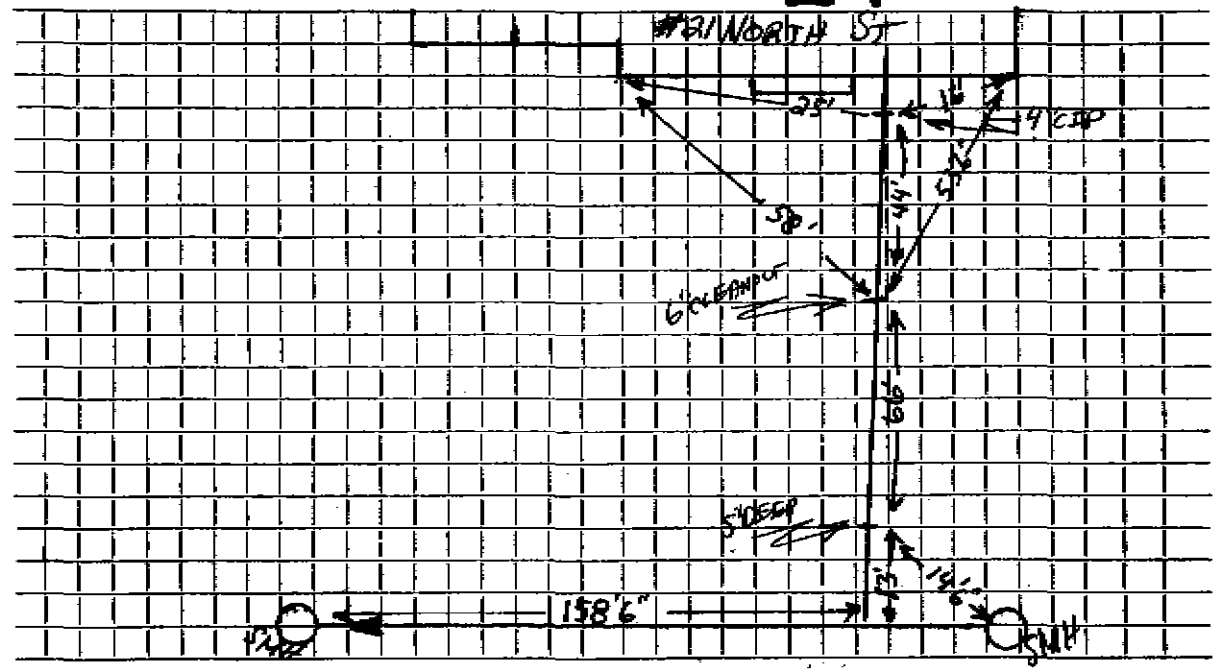

Connection made in NORTH ST Street. Work completed APRIL 11, 1984

Remarks: