

Name

Service No.

Address

22 North St

22 North St.

Location

Kind of Pipe

Size 6"

Size of Main 8"

Repair—Renewal—New Service

Location

Date

Material

Amount

Total

Date

Amount

~~9/21/83~~

~~16.5' 6" PVC~~

2.69

9-21-83


16.5' - 6" P.V.C.

→

DATE 10/28/83

TOWN OF LEXINGTON — BOARD OF PUBLIC WORKS
SEWER DIVISION

Sketch of Service Here **22**

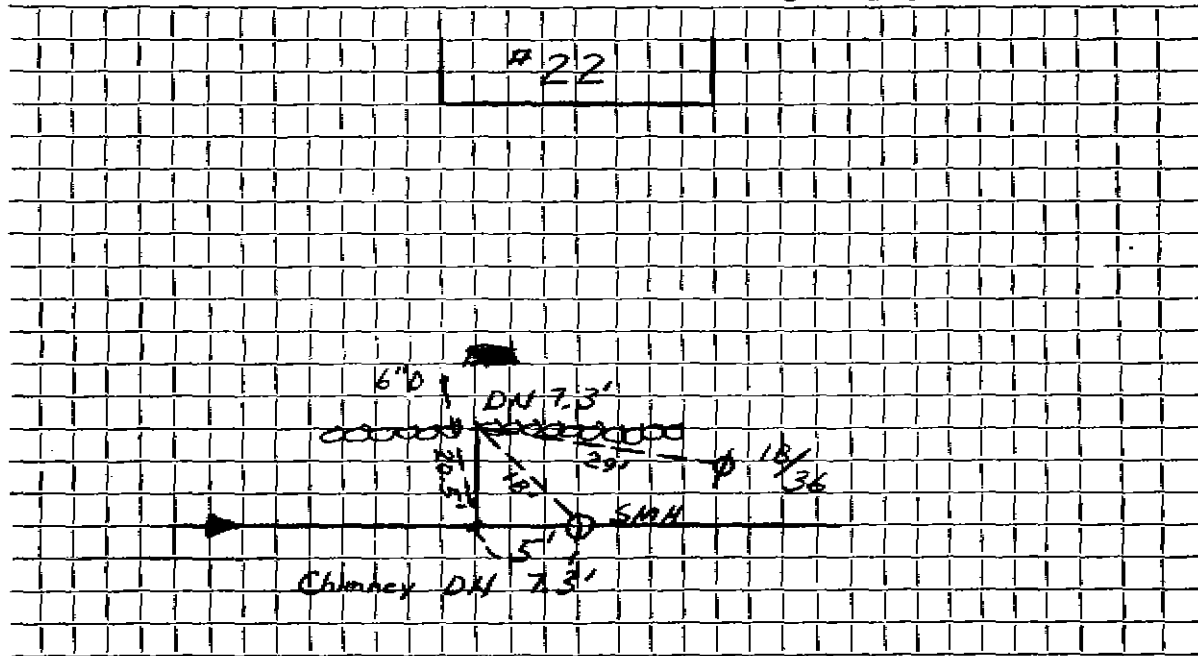

Connection made in NORTH Street. Work completed

Remarks:

.....
.....