

Name **Lawrence Jordan**

Service No. **17**

Address **3 North Street**

*Lot 5*

**3 North St**

Location

Kind of Pipe

Size **6"**

Size of Main **8"**

Repair—Renewal—New Service

**Eagle #1314**

Location **MAY 27 1969**

Date		Material	Amount	Total	Date		Amount
<del>ap 168</del>	<del>14'</del>	<del>6" Transite pipe</del>	<del>83.00</del>	112.00	4-28-69	Deposit	112.00
<del>28-69</del>	35'	6" Transite pipe					
	14'	4" Cast Iron pipe			9- -68		
						14' 6" Transite	
						1 6"x8" Wye	

1950


DATE \_\_\_\_\_

TOWN OF LEXINGTON — BOARD OF PUBLIC WORKS

SEWER DIVISION

Sketch of Service Here

3

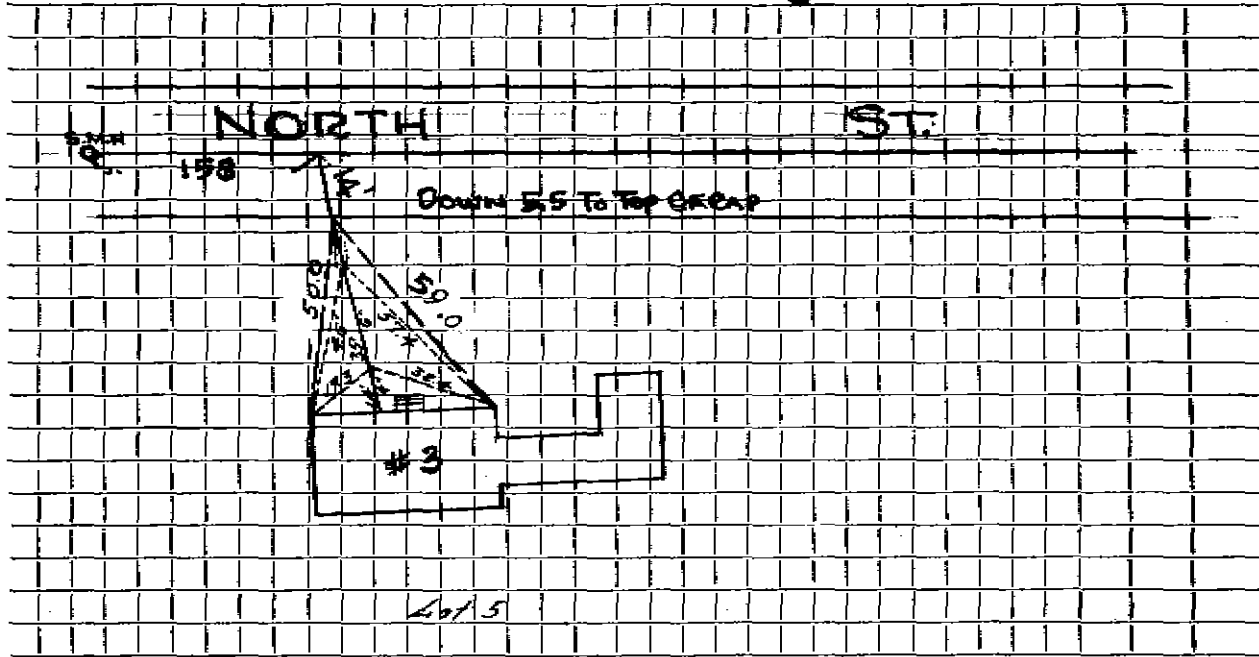

Connection made in ..... Street. Work completed .....

Remarks: .....

.....

.....