

三

Athenaeum 30 November 1871

30 North St.

Locality

Kind of Pipe

Size of Main C

Repair—General—New Service


Locution

DATE _____

TOWN OF LEXINGTON — BOARD OF PUBLIC WORKS
SEWER DIVISION

Sketch of Service Here

30

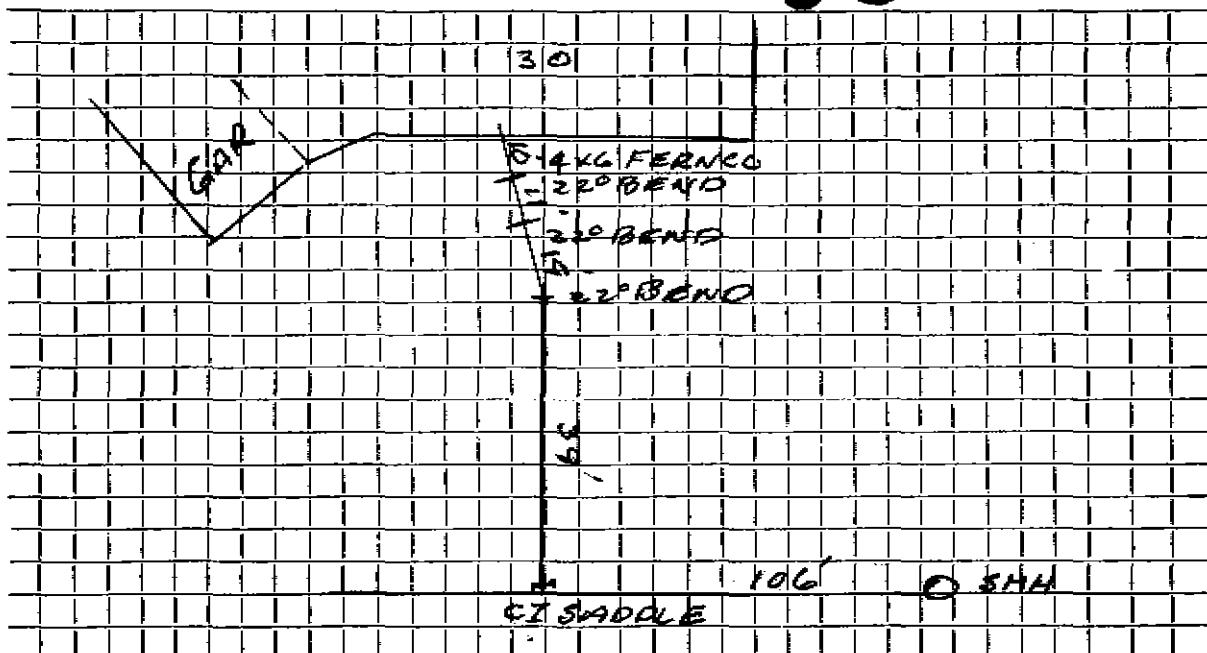

Connection made in NORTH Street. Work completed

Remarks:

.....