




TOWN OF LEXINGTON — BOARD OF PUBLIC WORKS  
SEWER DIVISION

Sketch of Service Here

352

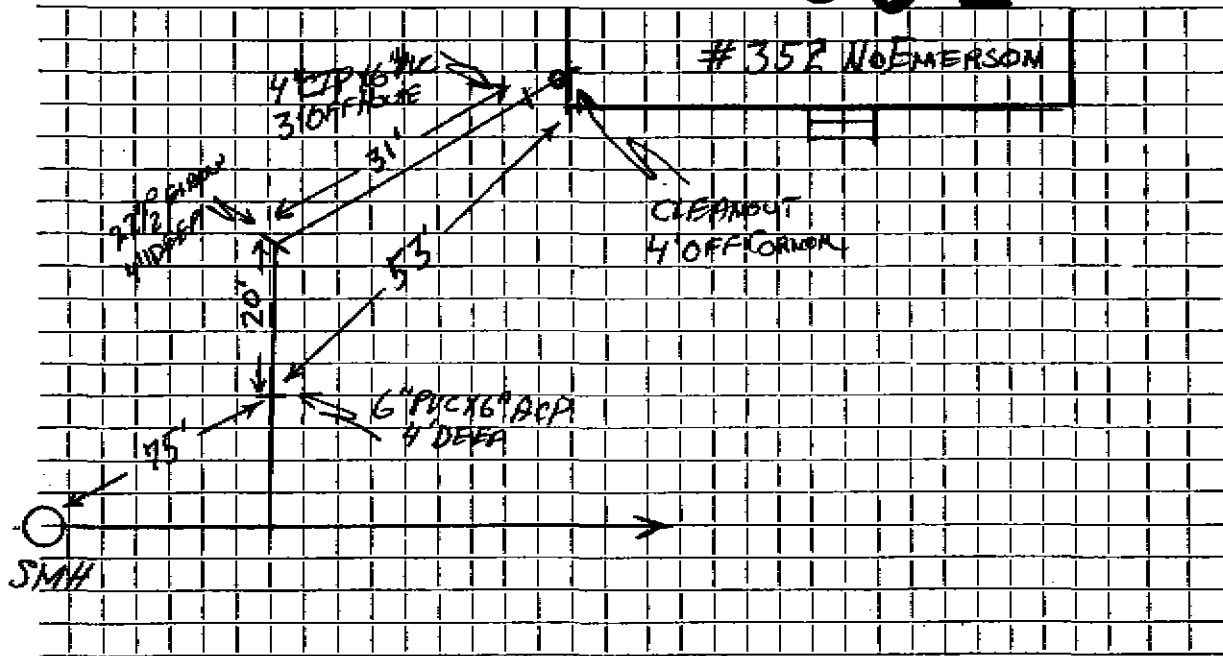

Connection made in No Emerson Rd Street. Work completed .....

Remarks: SERVICE REVIEWED TO PROP. LINE 8-5-83 .....