


DATE 11-8-83

TOWN OF LEXINGTON — BOARD OF PUBLIC WORKS
SEWER DIVISION

Sketch of Service Here **36**

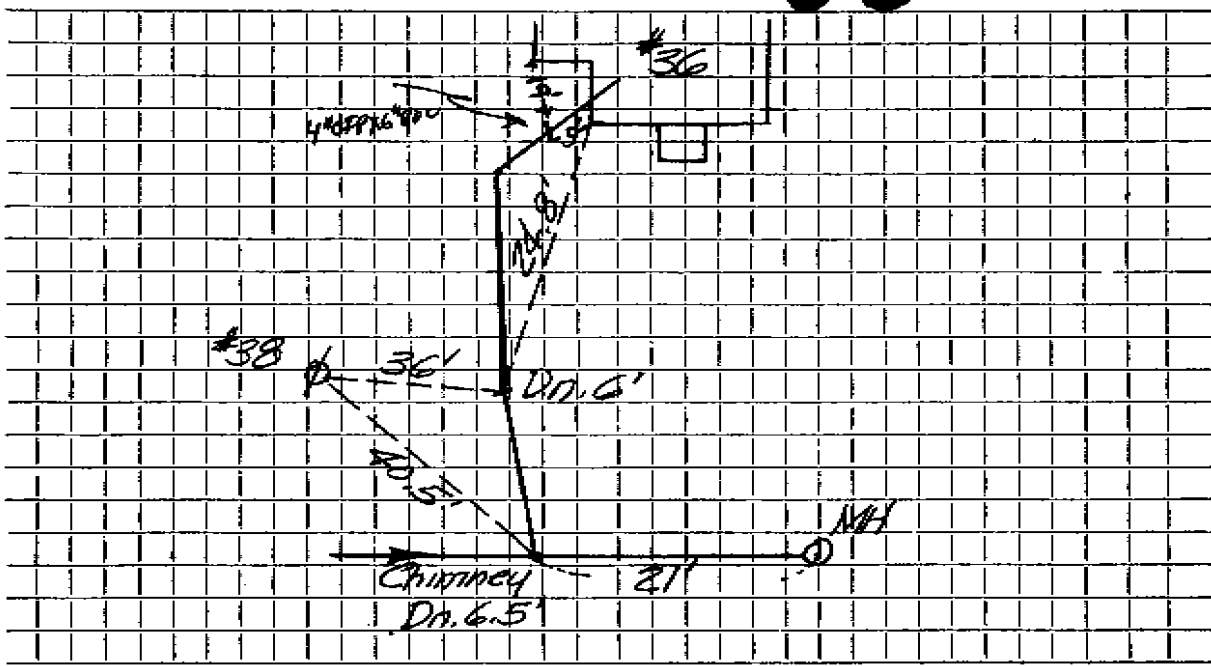

Connection made in North St. Street. Work completed 12-20-83

Remarks: