


DATE 11-8-83

TOWN OF LEXINGTON — BOARD OF PUBLIC WORKS
SEWER DIVISION

Sketch of Service Here **38**

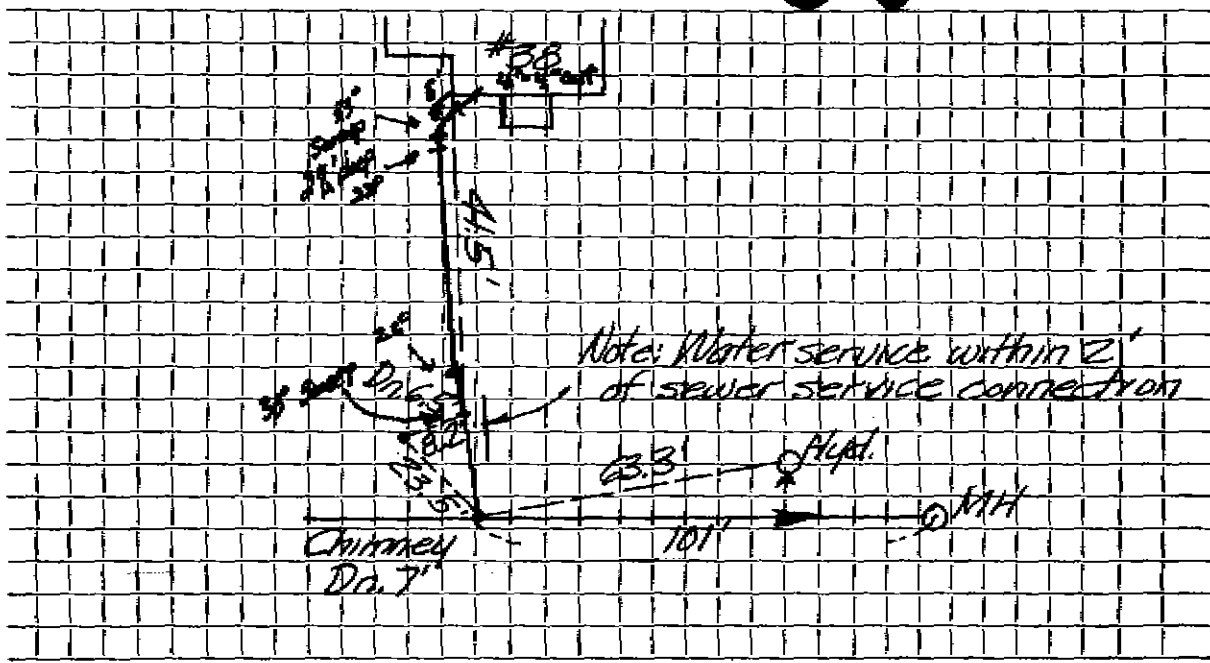

Connection made in North Street. Work completed

Remarks:
.....
.....