

Name John B. Butler

Service No. 14

Address

44 North St.

44 North ST.

Location

Kind of Pipe

Size 6"

Size of Main 8"

~~Renewal~~

New Service

Valeri #4462

Location


SEP 17 1984

Date	Material	Amount	Total	Date	Amount
9/26 83	20 LF 6" PVC	320 00		5-27-84	320 00
7/11/84	40' x 6" P.V.C.				Deposit
	10' x 4" C.I.P.			9-26-83	
	1 6" x 4" Donut			20' 6" P.V.C.	

DATE 11-8-83

TOWN OF LEXINGTON — BOARD OF PUBLIC WORKS
SEWER DIVISION

Sketch of Service Here **44**

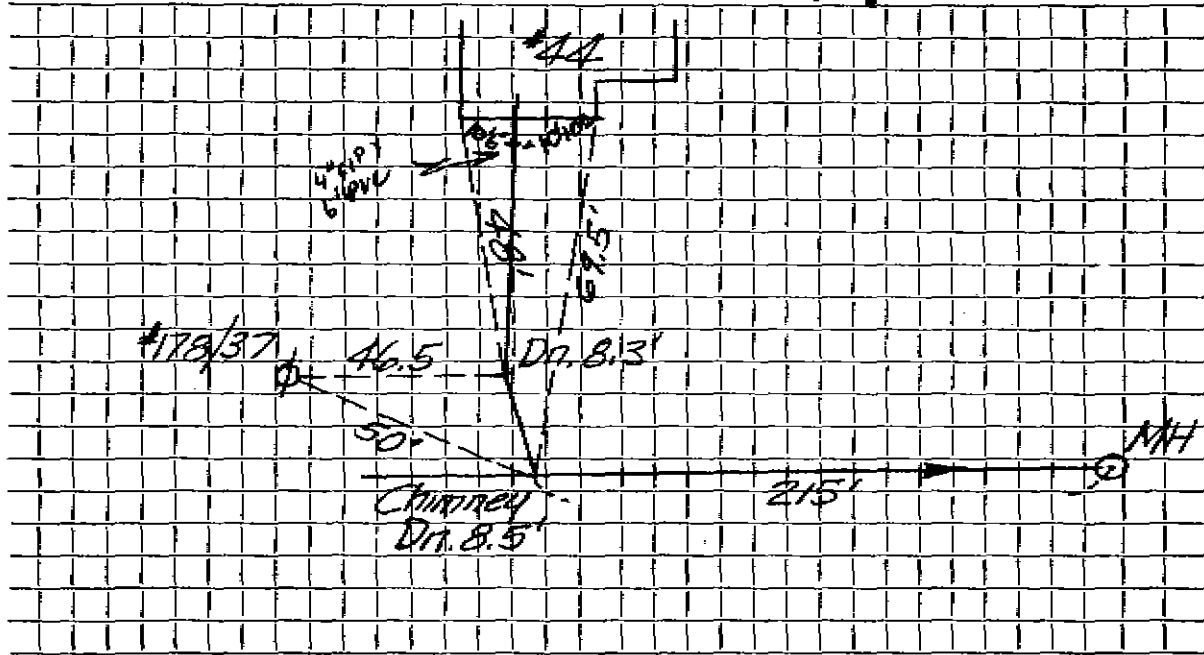

Connection made in North Street. Work completed July 11, 1984

Remarks: